


T. 5S. R. 10W. W.M.

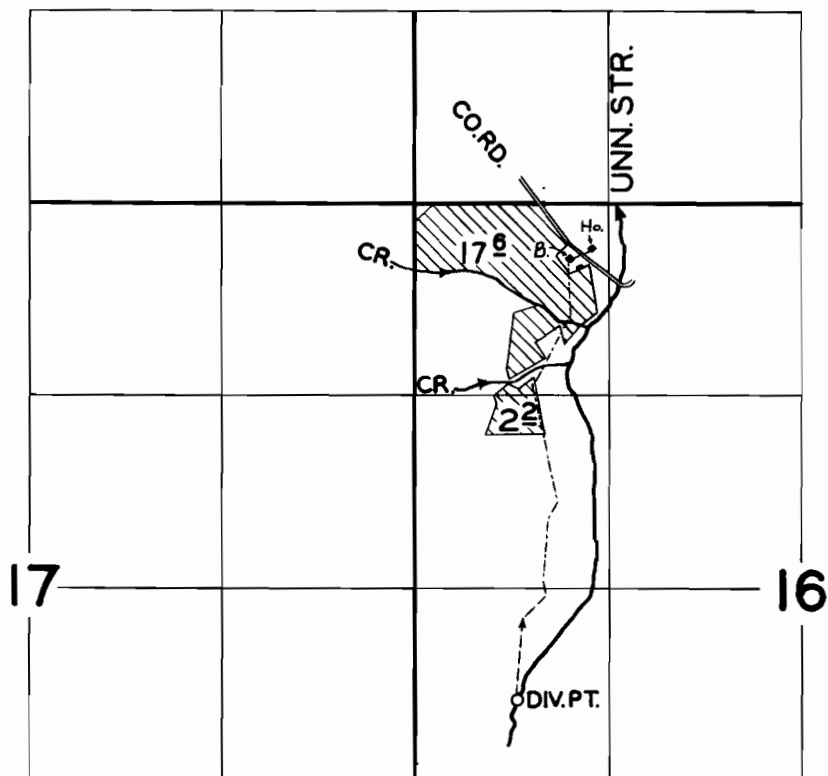

FINAL PROOF SURVEY
UNDER

Application No. 19670 Permit No. 15251
IN NAME OF

J. H. POWERS

Surveyed AUG. 29, 1957, by