


Per. 15690
24292

T. 8S. R. 31E. W.M.

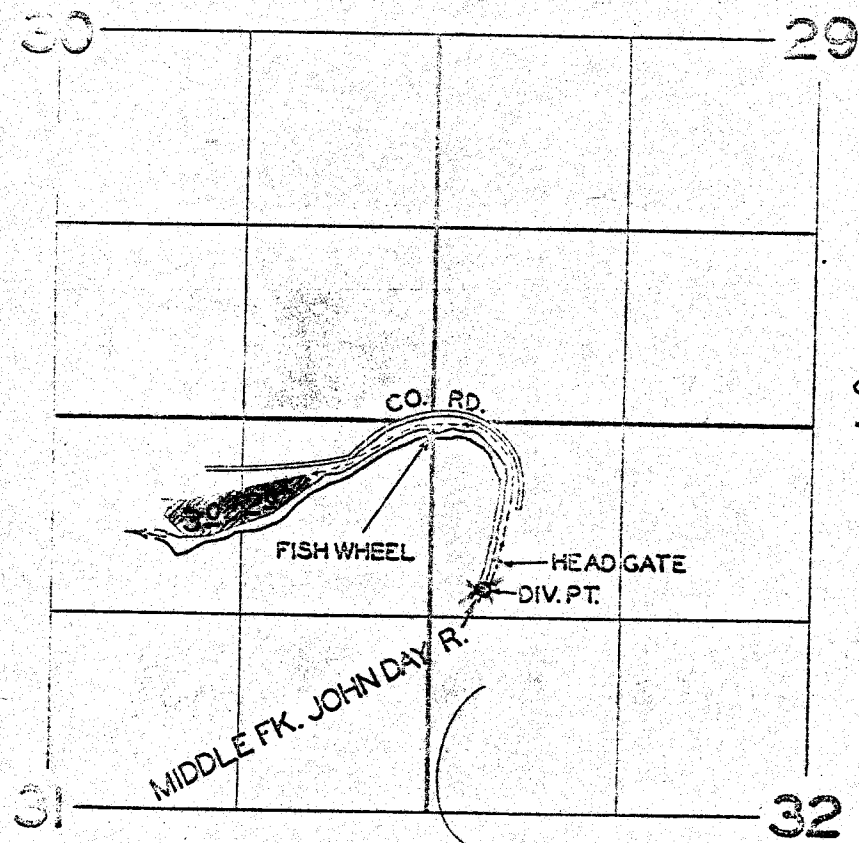

C-24292
1944
5.0

FINAL PROOF SURVEY
UNDER

Application No. 20127. Permit No. 15690
IN NAME OF

BELLE BIGNELL

Surveyed JULY 13, 1957, by *[Signature]*

[Handwritten mark]