


T.6S.R.5W.W.M.

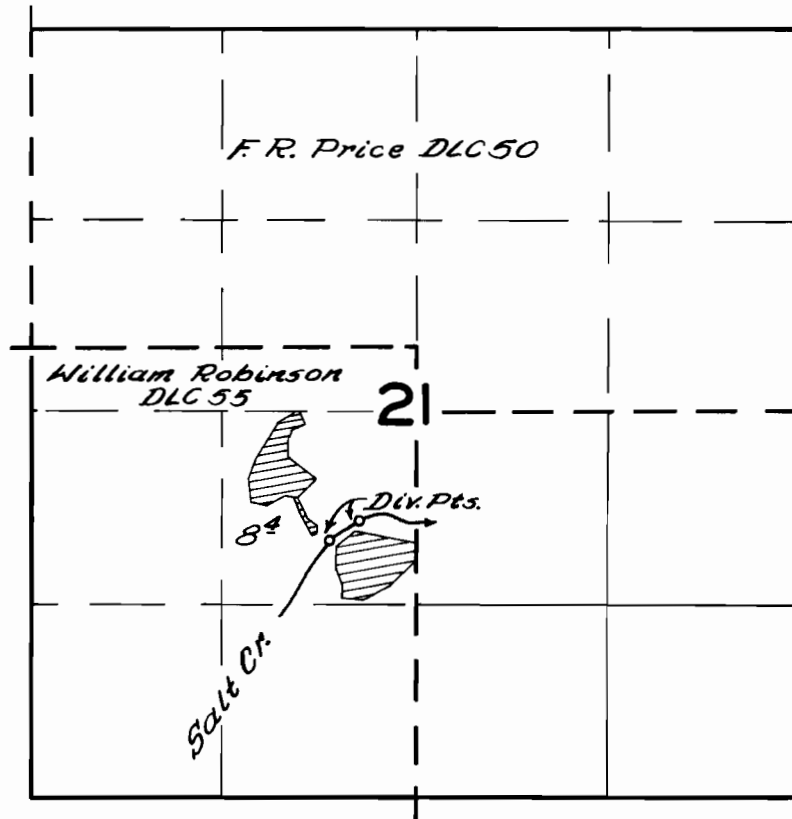

FINAL PROOF SURVEY
UNDER

Application No. 20173 Permit No. 15719
IN NAME OF

Theodore Rohde

Surveyed *Sept. 19 1957* by *C.O. Swartz*