


T. 3 N. R. 9 W. W.M.

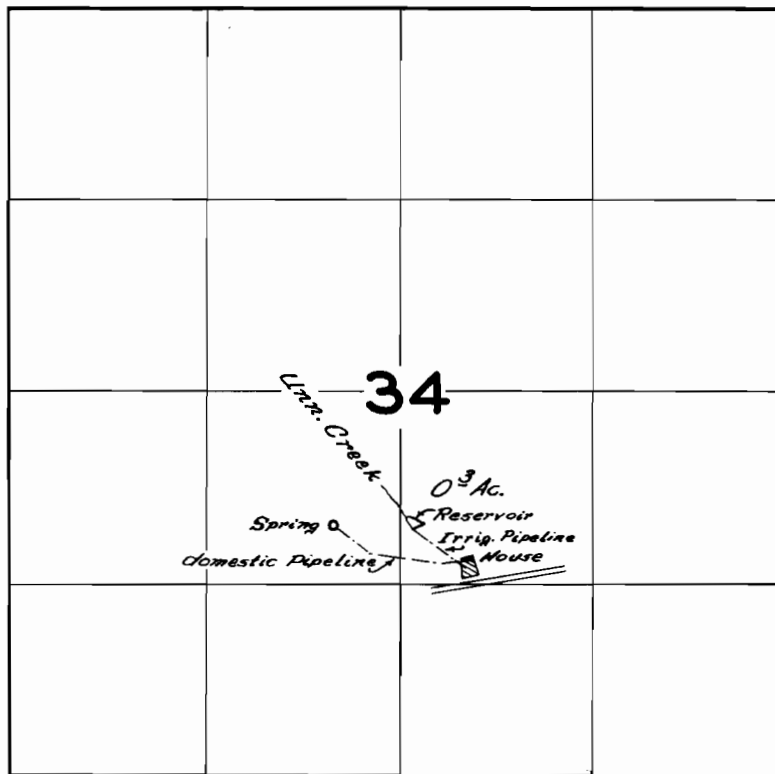

FINAL PROOF SURVEY
UNDER

Application No. 20982 Permit No. 16424
IN NAME OF

Yunker & Wiecks

Surveyed *Sept. 10, 1957*, by *C.O. Baugh*