


T. 19S. R. 12W. W.M.

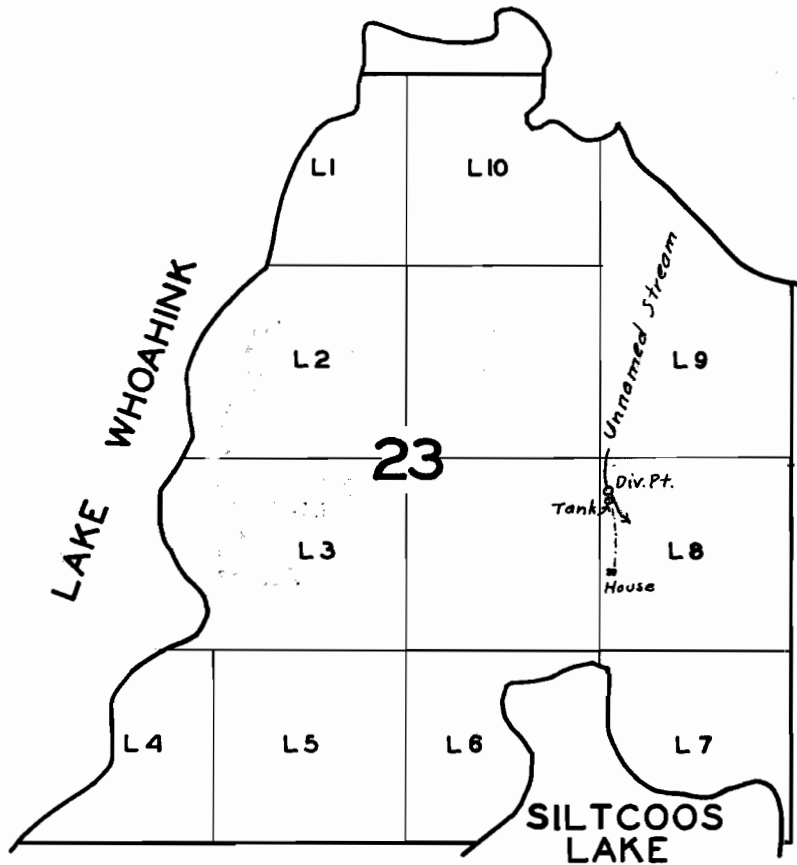

**FINAL PROOF SURVEY**  
UNDER

Application No. 23377 Permit No. 18456  
IN NAME OF

CARLTON MERLE ZANE

Surveyed JUNE 12 1957, by *[Signature]*