


T.18S.R.11W.W.M.

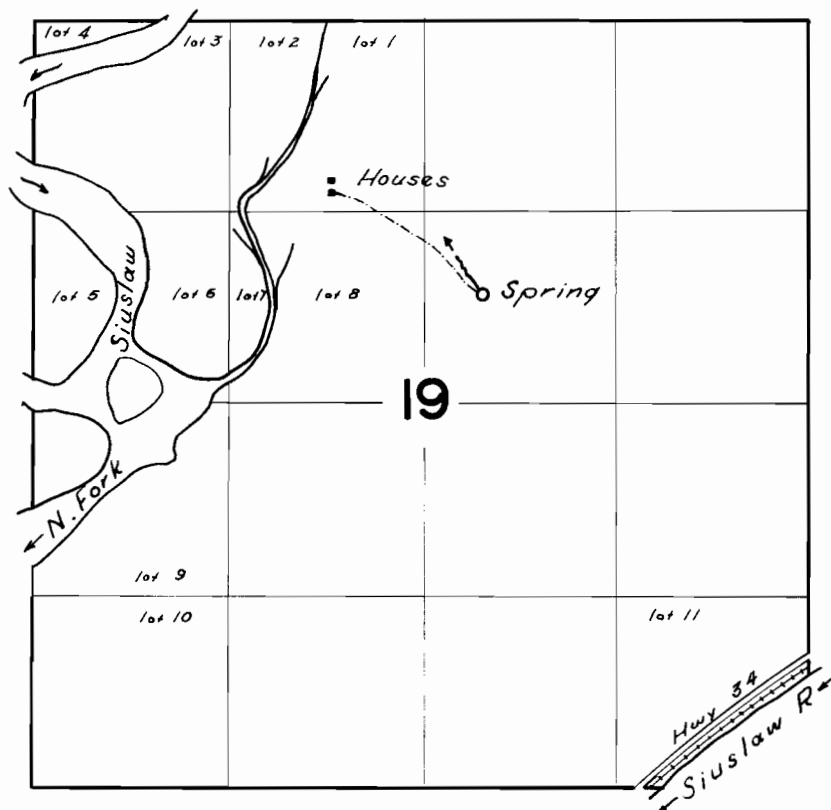

FINAL PROOF SURVEY
UNDER

Application No. 23399 Permit No. 18472
IN NAME OF

FRED & VIOLA DOWDY

Surveyed 11 Aug 1954, by T. JONES