


T. 35 S., R. 4 W., W.M.

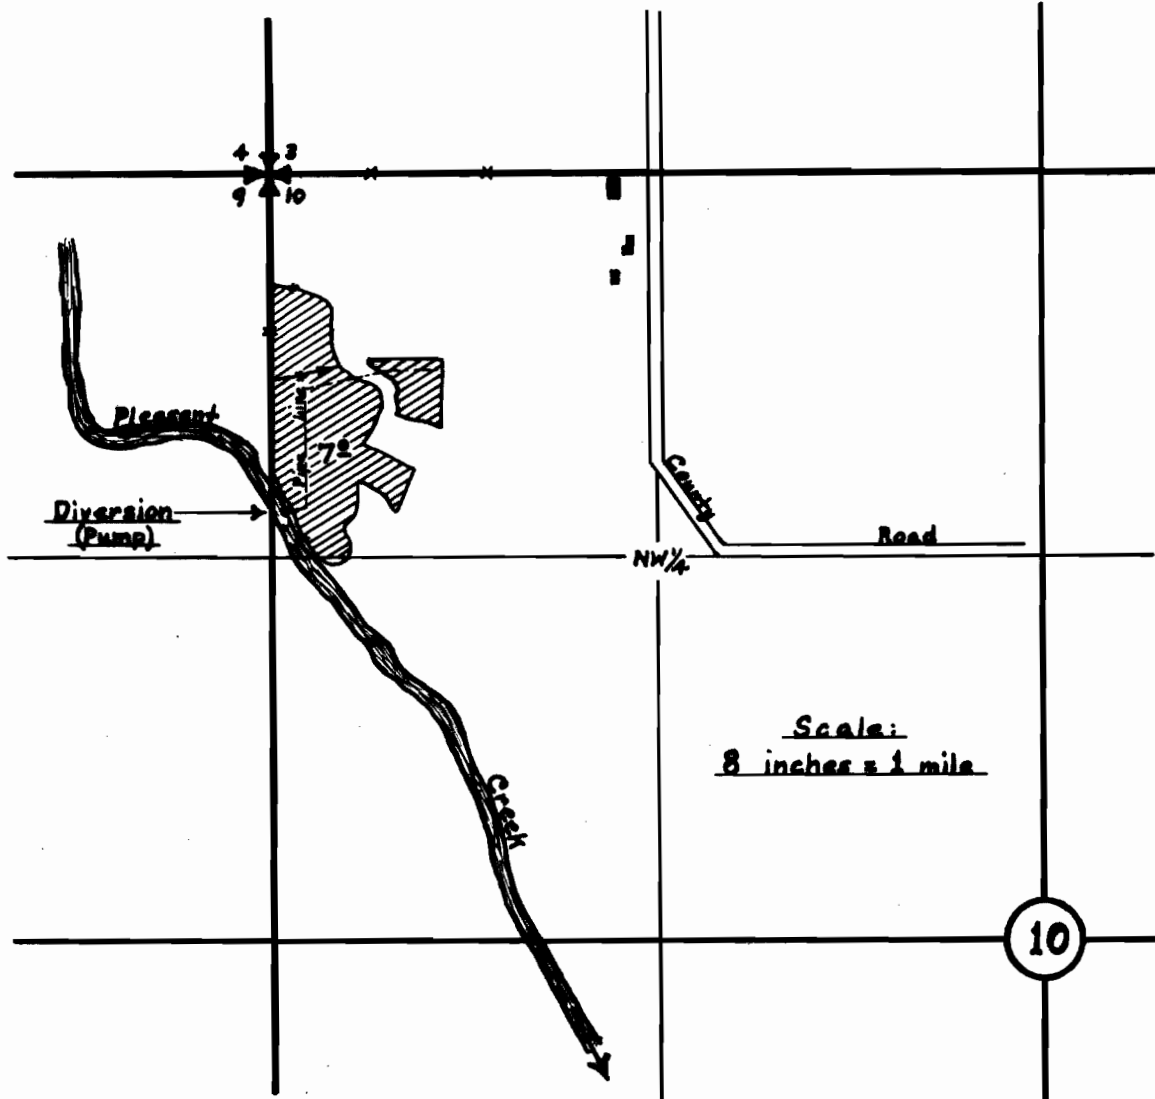

**FINAL PROOF SURVEY**  
UNDER

Application No. 23520... Permit No. 18609....  
IN NAME OF

George H. Johnston

Surveyed March 27, 1958., by David C. Hendrix, W.M.