


T. 2S. R. 10W. W.M.

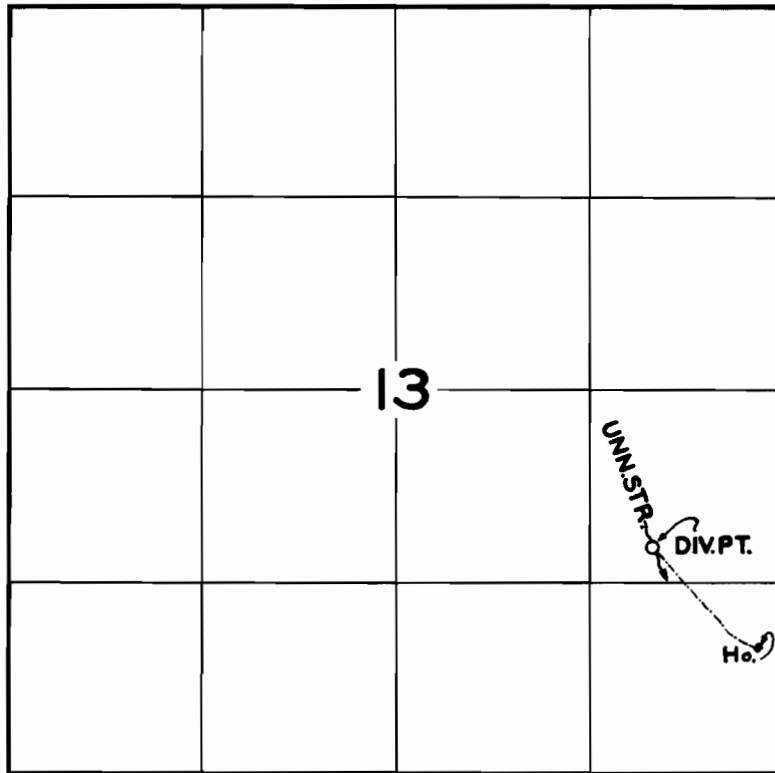

FINAL PROOF SURVEY
UNDER

Application No. 23719 Permit No. 18731
IN NAME OF

EMMA & BERNARD GROSSEN

Surveyed AUG. 26. 1957, by *Arthur Kelly*