


T.10S.R.7W.W.M.

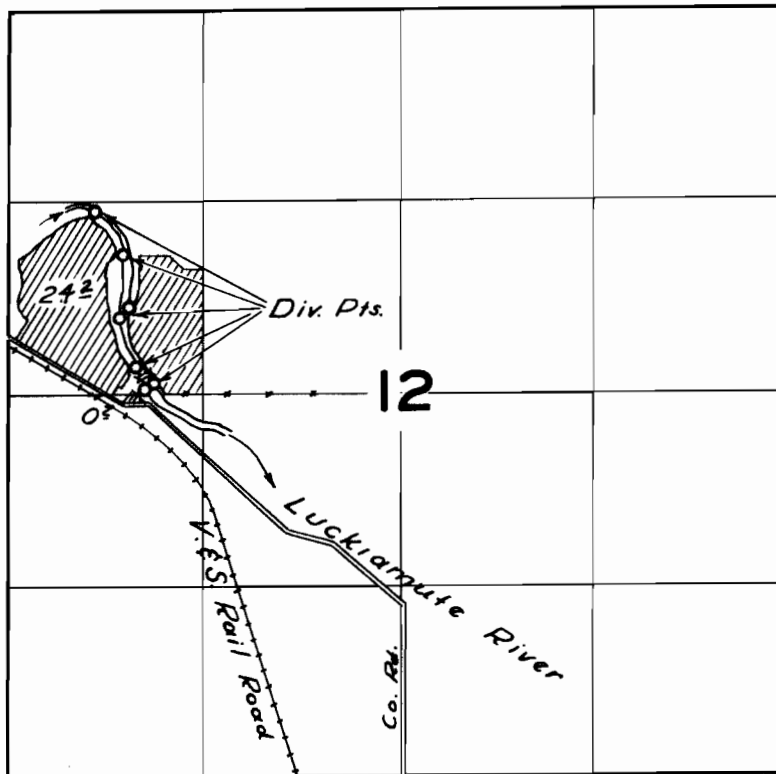

FINAL PROOF SURVEY
UNDER

Application No. 23753 Permit No. 18751
IN NAME OF

R. D. STANLEY

Surveyed 5 Sept. 1957, by [Signature]