


T.9 S.R. I E.W.M.

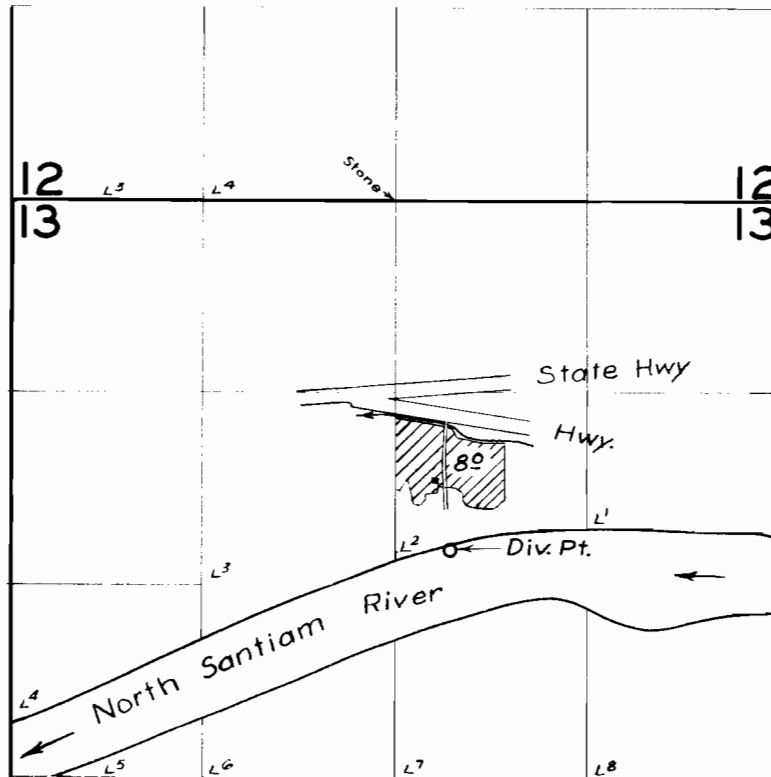

FINAL PROOF SURVEY UNDER

Application No. 24034. Permit No. 18948.
IN NAME OF

A.W. Bellin

Surveyed Aug. 29, 1957, by *m. Bah*