


T. 4S. R. IW.W.M.

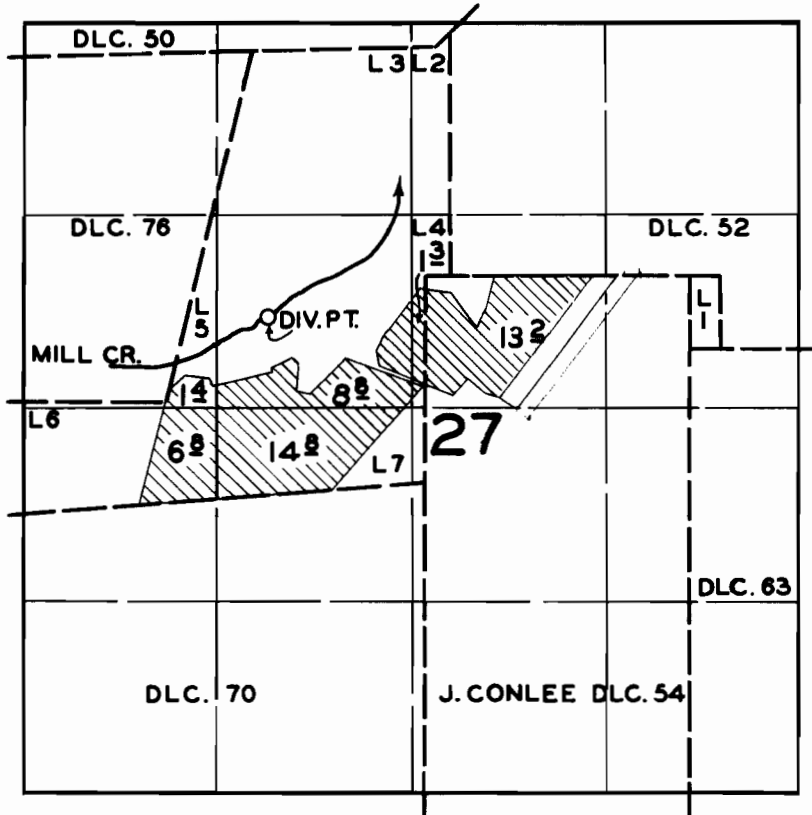

FINAL PROOF SURVEY  
UNDER

Application No. 23668. Permit No. 19172  
IN NAME OF

ALBERT C. BRUNDAGE

Surveyed SEPT. 5 1957, by *C.O. Burt*