


T.9 S.R.1 E.W.M.

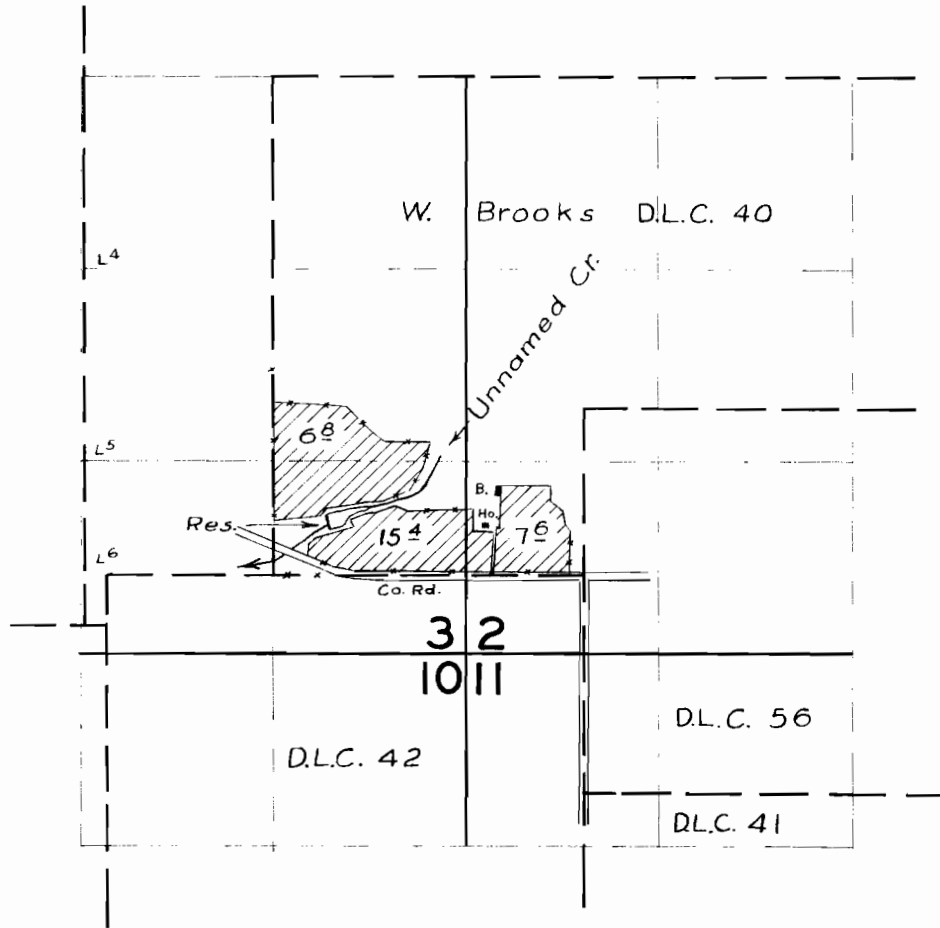

FINAL PROOF SURVEY UNDER

Application No. 24611 Permit No. 19384
IN NAME OF

Frank Etzel

Surveyed Aug. 28 1957, by *M. Bieh*