


T. I O S. R. I E. W. M.

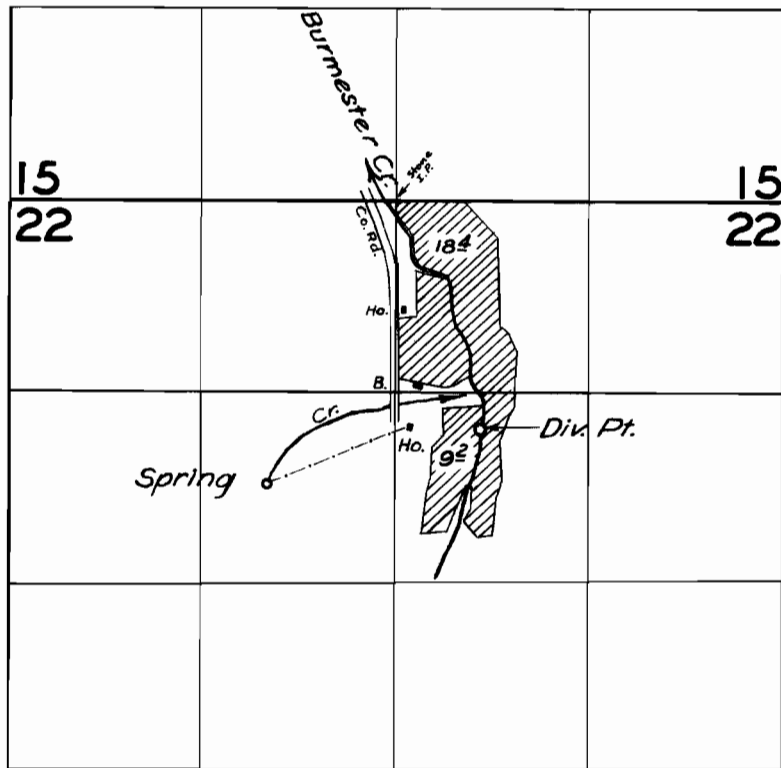

FINAL PROOF SURVEY
UNDER

Application No. 25240 Permit No. 19965
IN NAME OF

Raymond Silbernagel

Surveyed June 4 1957, by m. Bish