


T. 2S. R. 9W. W.M.

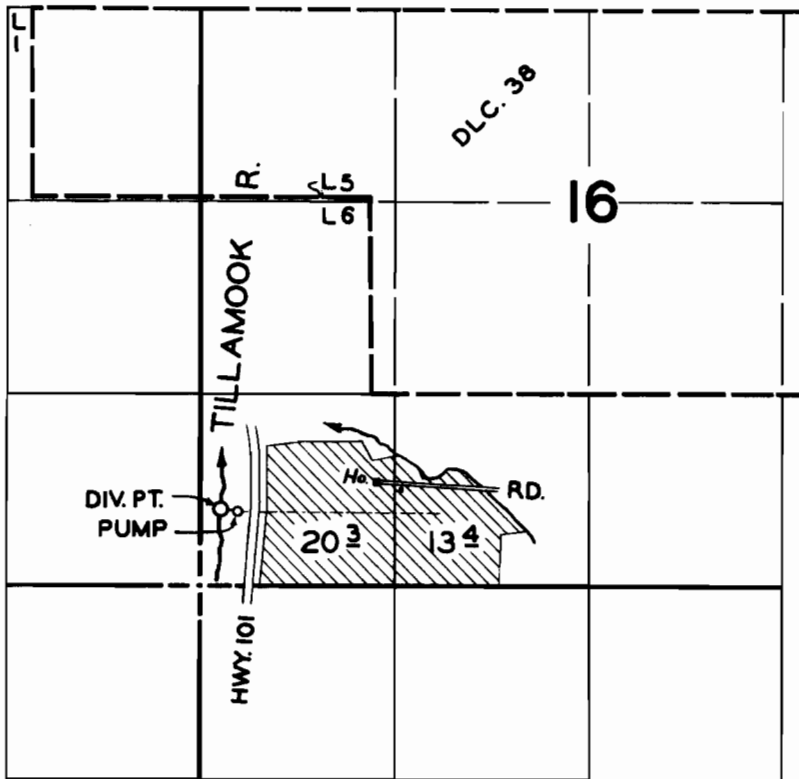

**FINAL PROOF SURVEY**  
UNDER

Application No. 25466. Permit No. 20018.  
IN NAME OF

**GOTTFRIED & MARTHA FOSSBIND**

Surveyed AUG. 27. 1957, by *[Signature]*