


T.28 S.R.8 W.W.M.

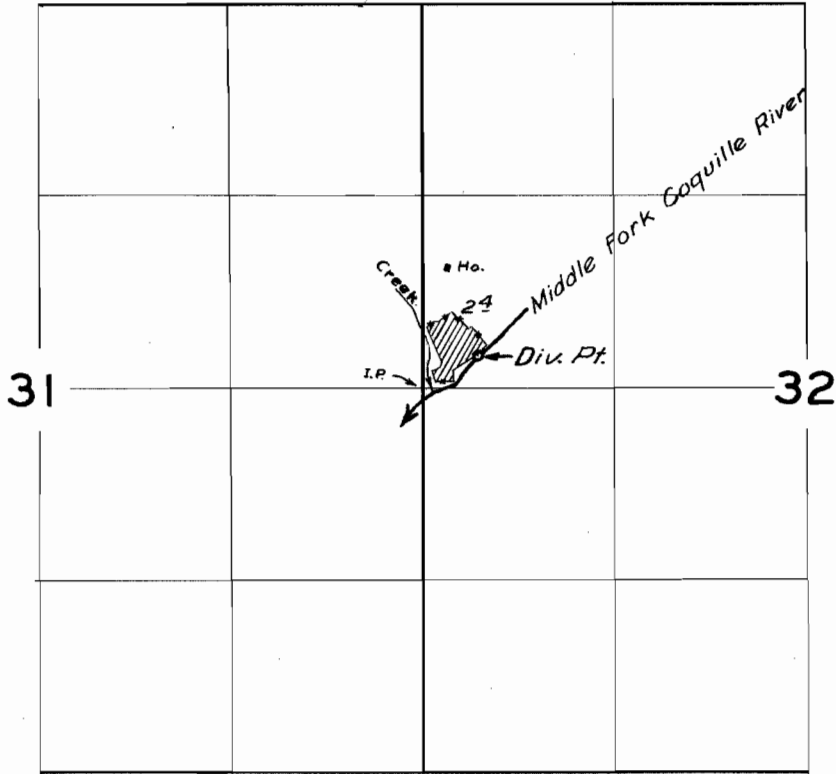

FINAL PROOF SURVEY
UNDER

Application No. 25661 Permit No. 20122
IN NAME OF

Richard Thrush

Surveyed Aug. 17, 1957, by M. Bish