


T.14S. R.6W. W.M.

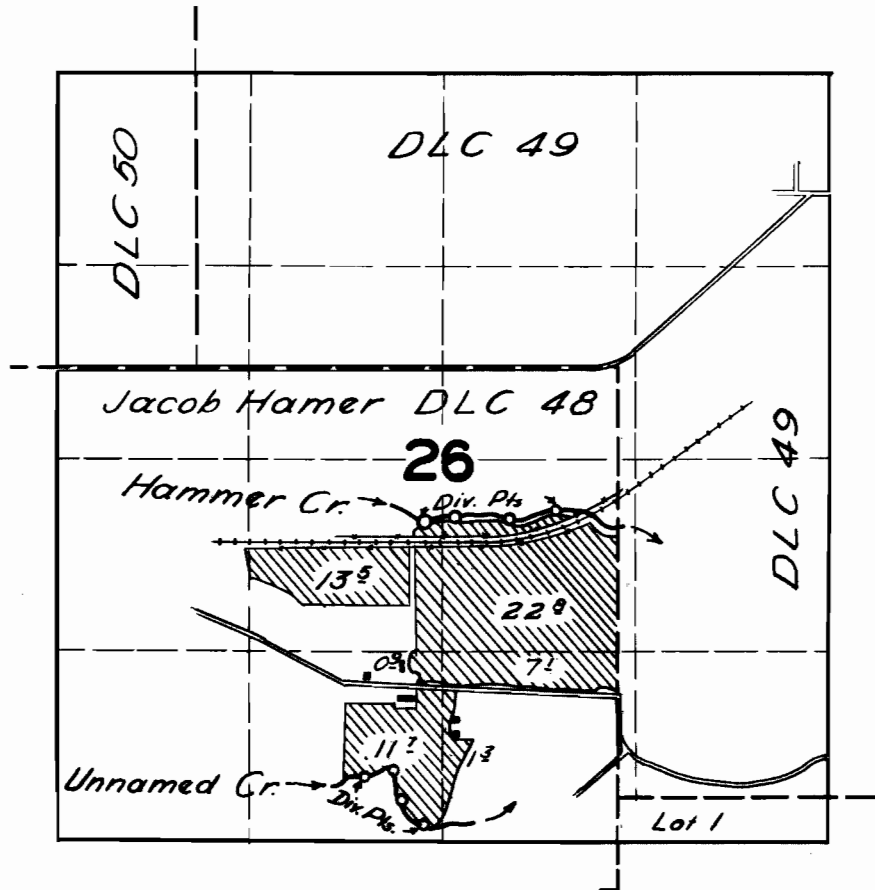

FINAL PROOF SURVEY

UNDER

Application No. 25958 Permit No. 20350

IN NAME OF

J. E. LARKIN

Surveyed 22 Apr. 1957, by [Signature]