


T.22 S.R.6 W.W.M.

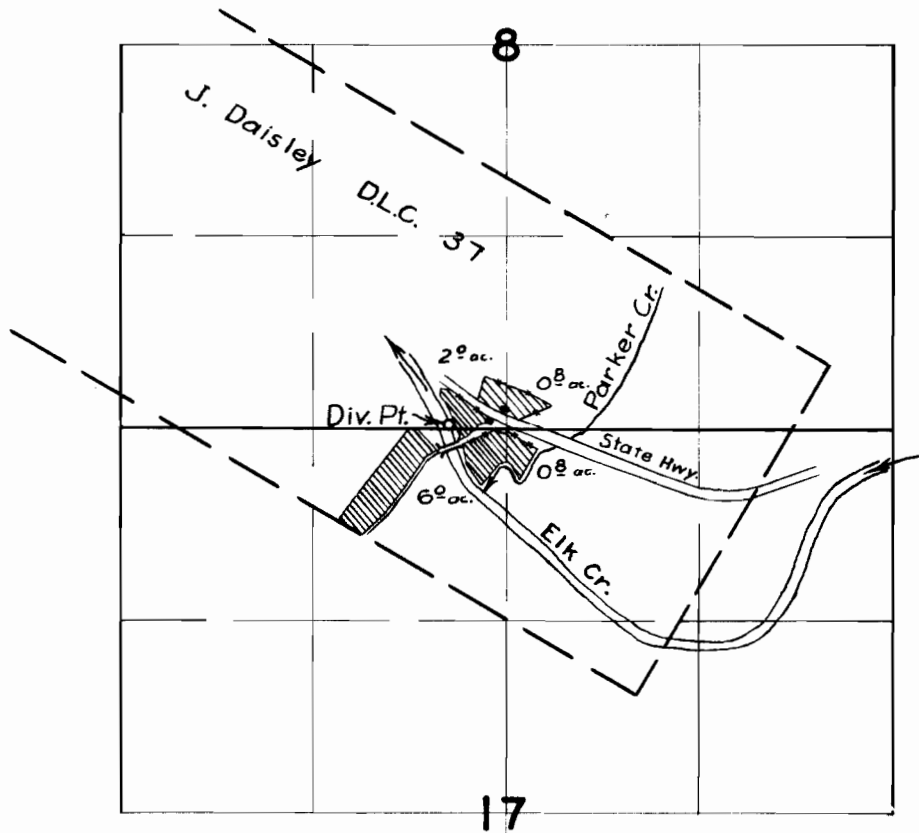

FINAL PROOF SURVEY UNDER

Application No. 26066 Permit No. 20391
IN NAME OF

Juanita Telkamp Seelye

Surveyed Sept. 8, 1957, by M. Bush