


T.16S. R.14E. W.M.

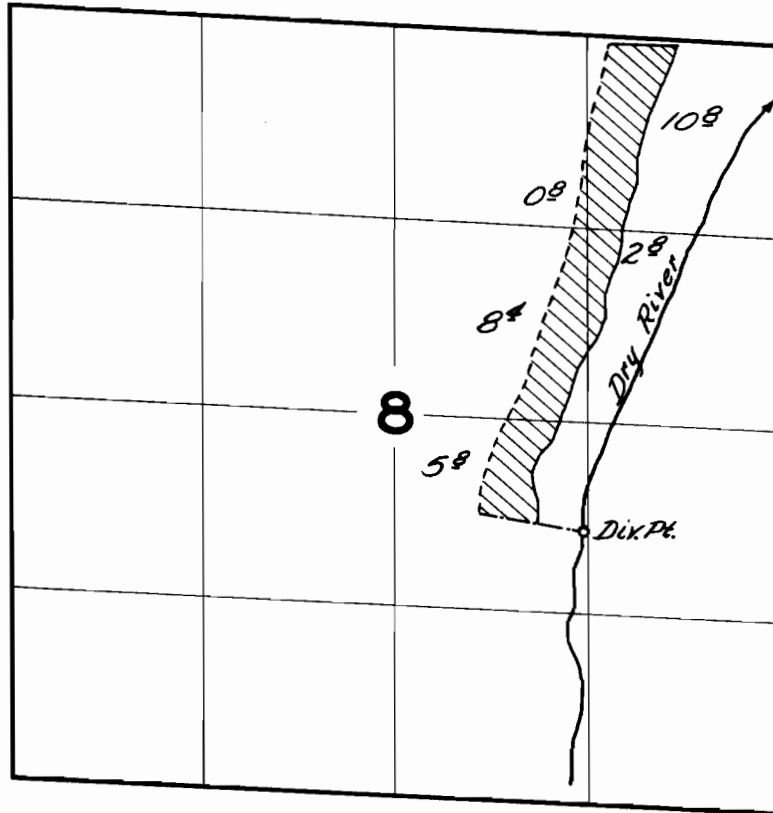

FINAL PROOF SURVEY
UNDER

Application No. 26083. Permit No. 20396.
IN NAME OF

..... *Jack McCaffery*

Surveyed *Aug. 8*, 1957, by *C.D. Barth*.....