


T. 4N. R. 37E. W.M.

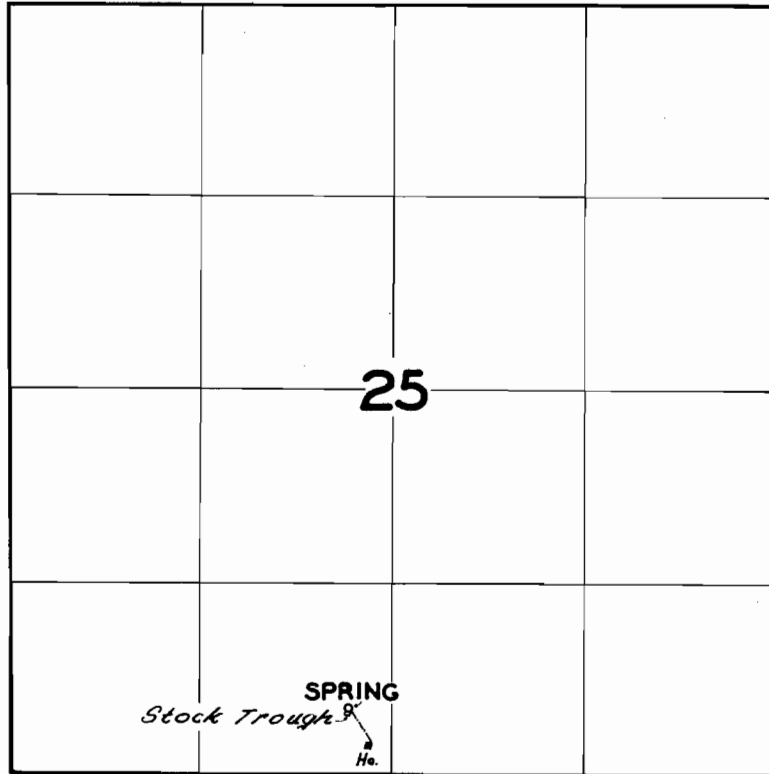

FINAL PROOF SURVEY
UNDER

Application No. 25691 Permit No. 20516
IN NAME OF

W.H. FRAZIER

Surveyed JUNE 5, 1957, by C.O. Bartlett