


T. 7S. R. 1E. W.M.

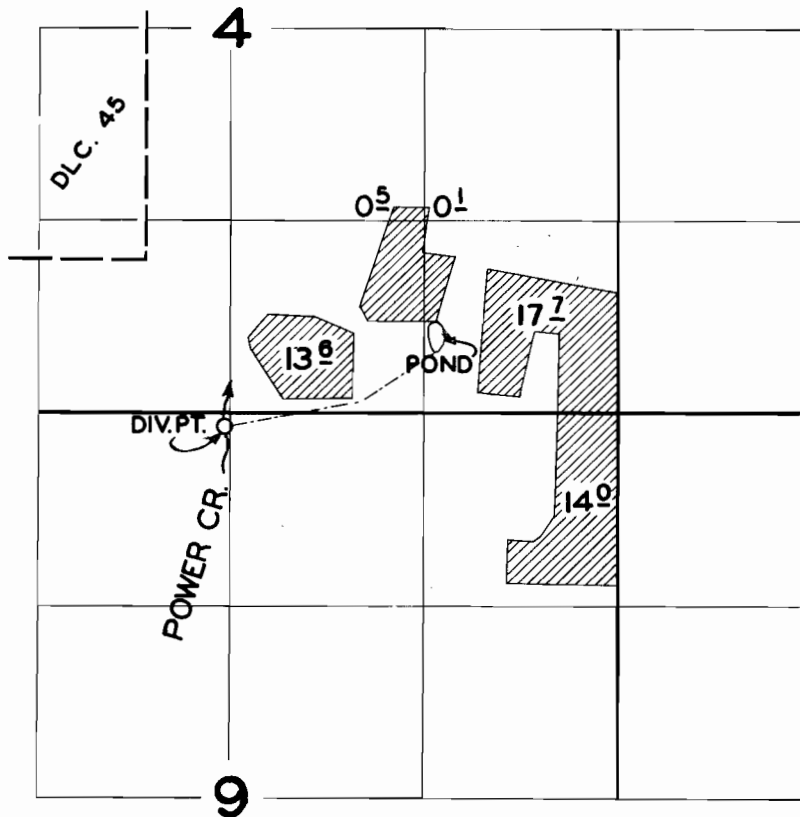

FINAL PROOF SURVEY
UNDER

Application No. 26239 Permit No. 20604
IN NAME OF

BRADFORD A. EDWARDS

Surveyed SEPT. 6 1957, by *C. O. Burtels*