


T.13S.R.5W.W.M.

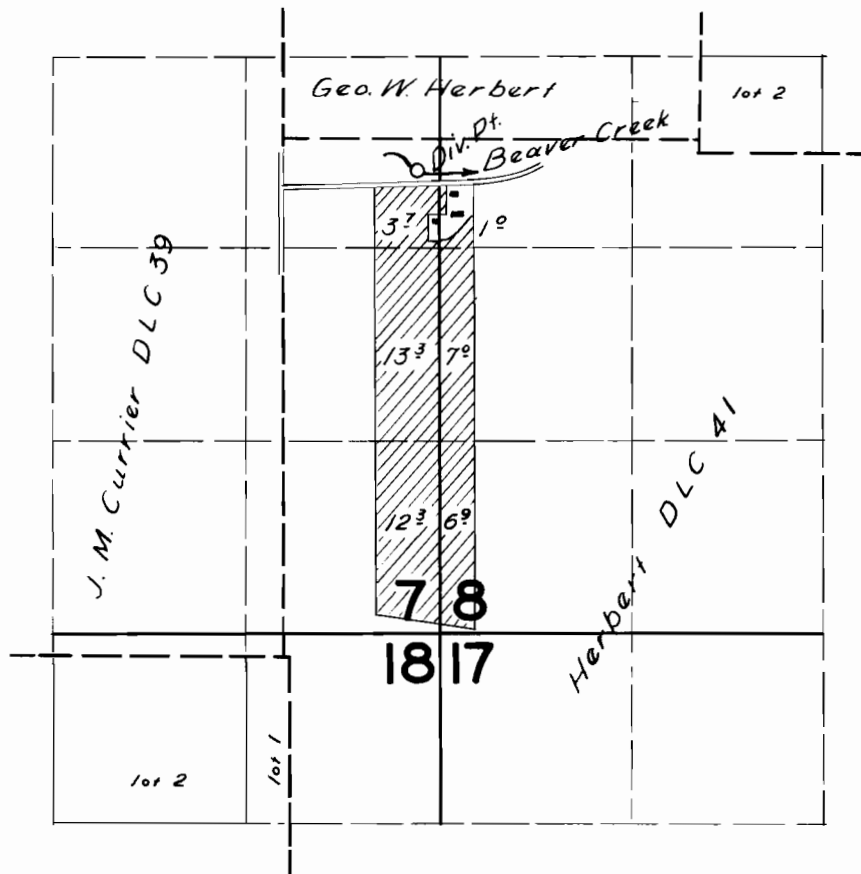

**FINAL PROOF SURVEY**  
UNDER

Application No. 26636 Permit No. 20867  
IN NAME OF

HOLLAS EVANS

Surveyed 6 Sept. 1957, by [Signature]