


T. 2 N., R. 3 W., W.M.

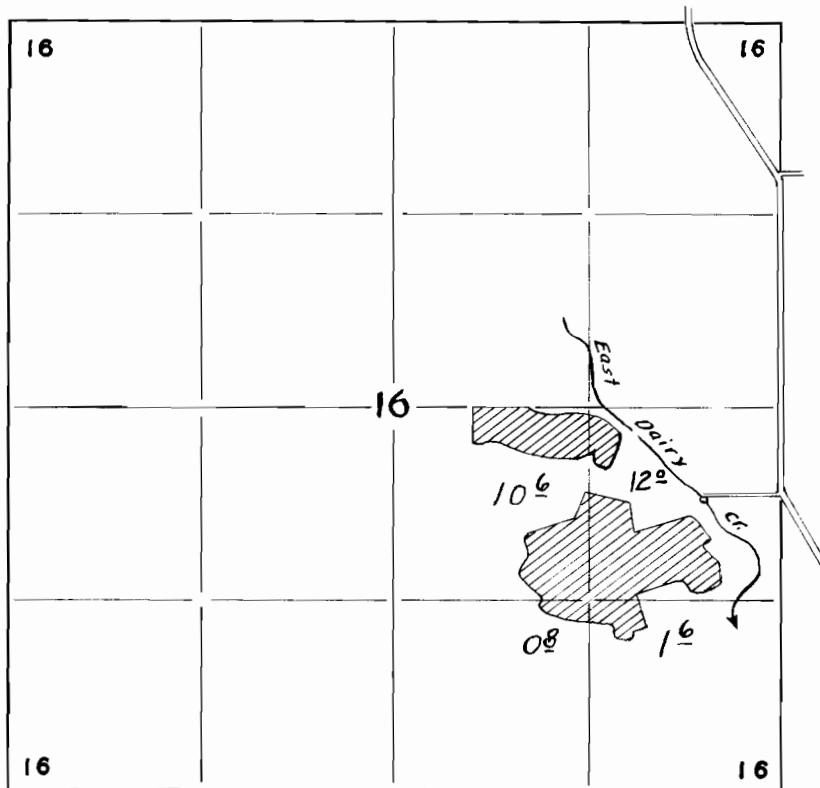

FINAL PROOF SURVEY

UNDER

Application No. 26655 Permit No. 20877

IN NAME OF

W. D. & PAULINE K. FOWLES

Surveyed 4-11-1956 by R.H. WHITBY