


T. 18S. R. 10W. W.M.

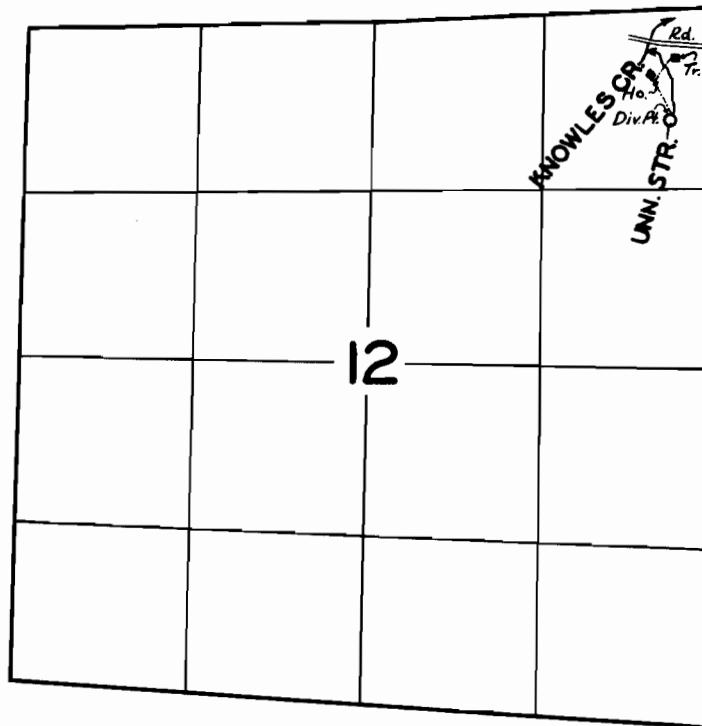

FINAL PROOF SURVEY
UNDER

Application No. 25528 Permit No. 20971
IN NAME OF

Irvin D. Custer

Surveyed MAY 24 1957, by