


T.9 S.R.1 E.W.M.

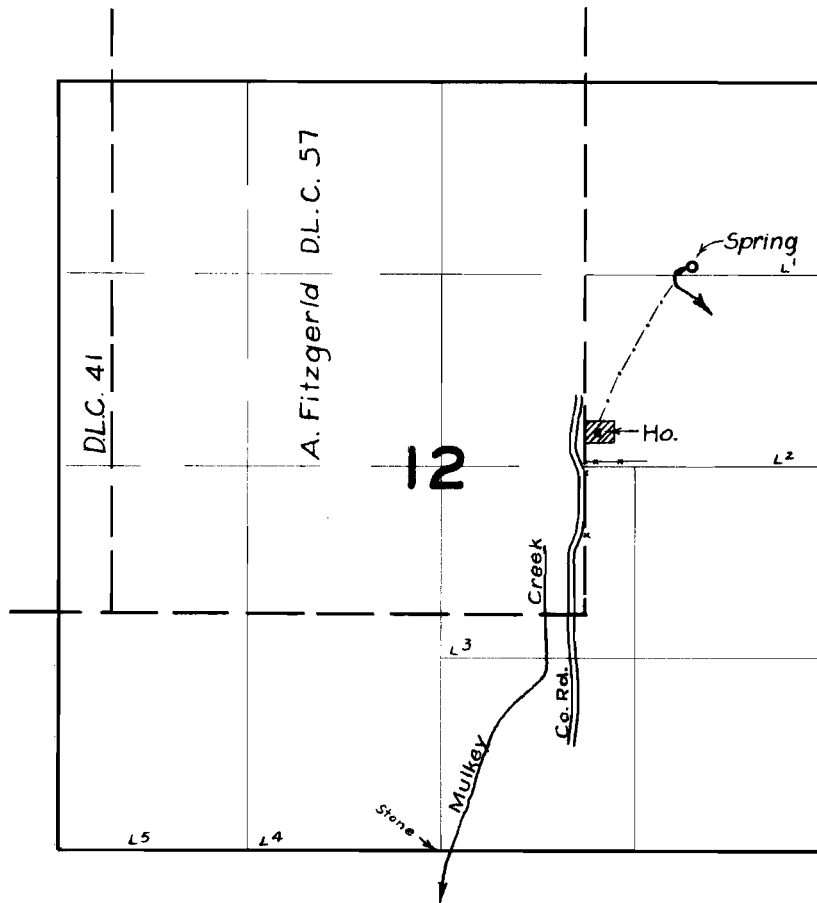

FINAL PROOF SURVEY UNDER

Application No. 25998 Permit No. 20986
IN NAME OF

Charles P. Bouche

Surveyed Aug. 29 1957, by M. Bish