


T.30S.R.4W.W.M.

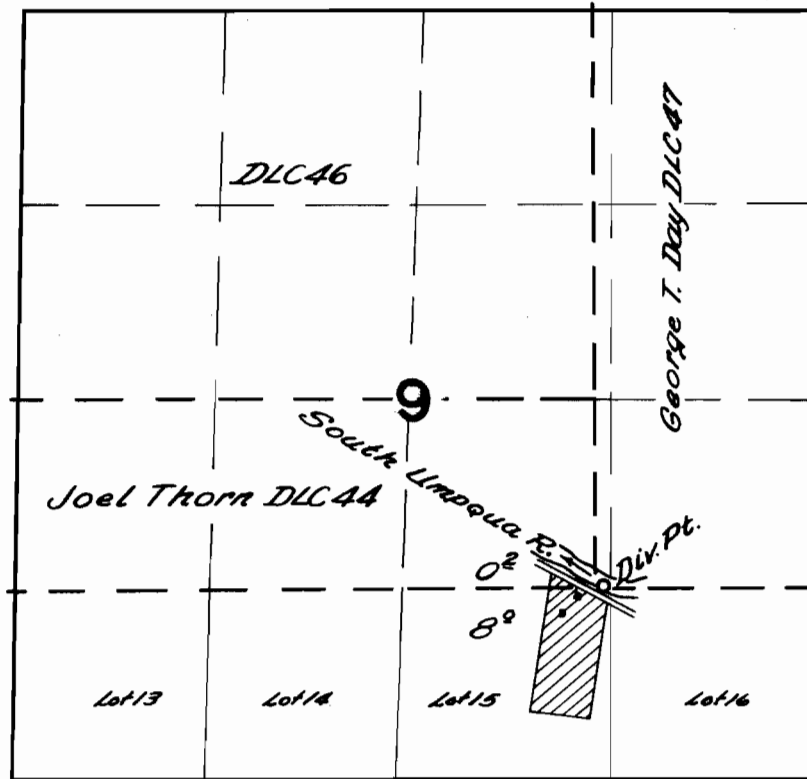

FINAL PROOF SURVEY
UNDER

Application No. 26784 Permit No. 21043
IN NAME OF

J. J. SMITH

Surveyed Oct. 16, 1956, by [Signature]