


T. 29+30S. R. 3W.W.M.

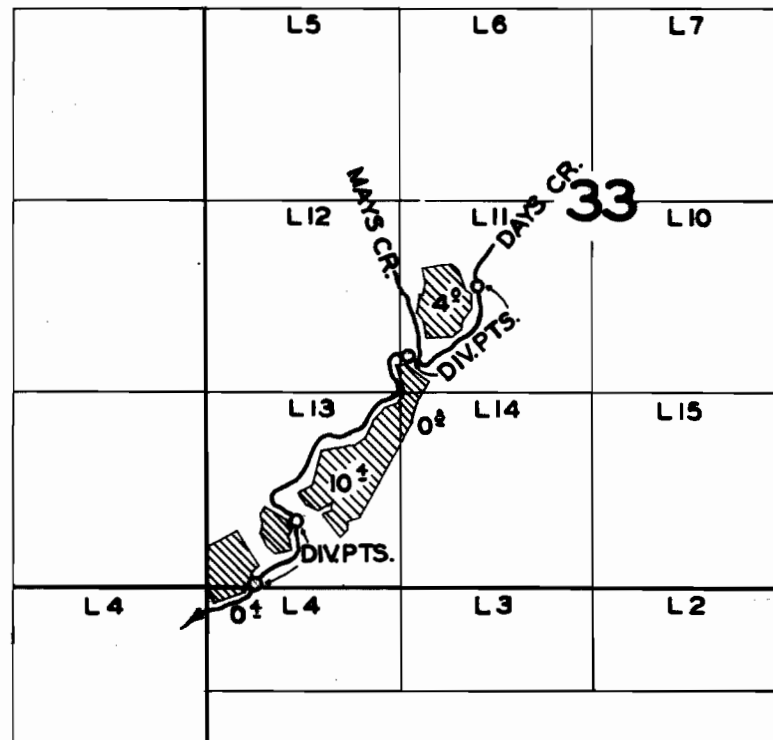

FINAL PROOF SURVEY
UNDER

Application No. 26874 Permit No. 21101
IN NAME OF

V.H. & LOIS BENNETT

Surveyed JUNE 27, 1957, by C.O. BARTELS