


T.9S.R.5W.W.M.

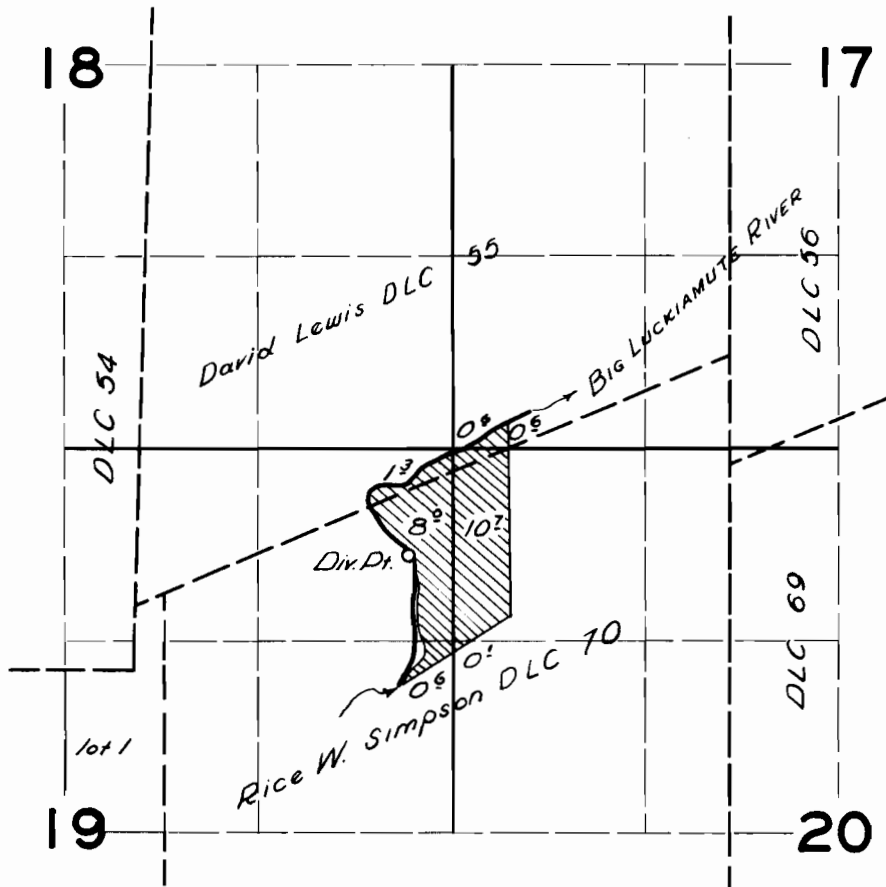

FINAL PROOF SURVEY
UNDER

Application No. 26724 Permit No. 21123
IN NAME OF

IVAN & CLEONE WILLIAMS

Surveyed 2 April 1957, by *[Signature]*