


T.6S.R.7W.W.M.

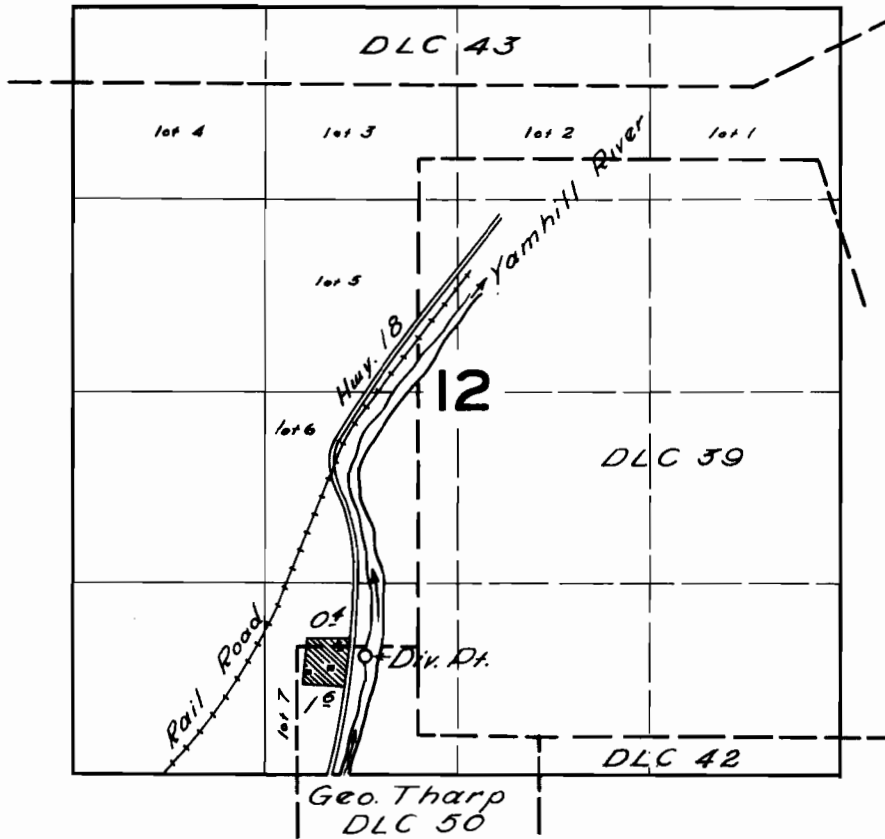

FINAL PROOF SURVEY
UNDER

Application No. 27161 Permit No. 21361
IN NAME OF

WILLIAM S. & HAZEL J. KENNEDY

Surveyed 29 July 1957, by [Signature]