


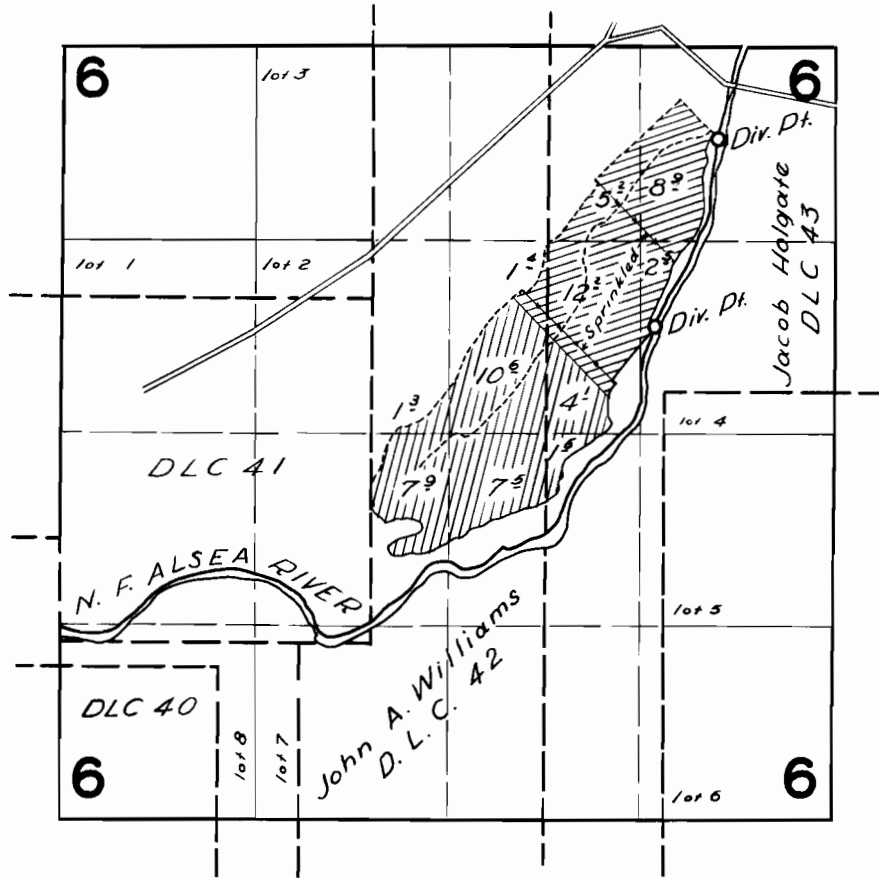

T.14S.R.7W.W.M.



FINAL PROOF SURVEY UNDER

18903 14589 
 Application No. 27309 Permit No. 21476 
 IN NAME OF

JOHN W. BUSTER & EDNA V. WHEELER

Surveyed 23 Aug. 1957, by *P. A. Kelly*