


T.17S.R.5W.W.M.

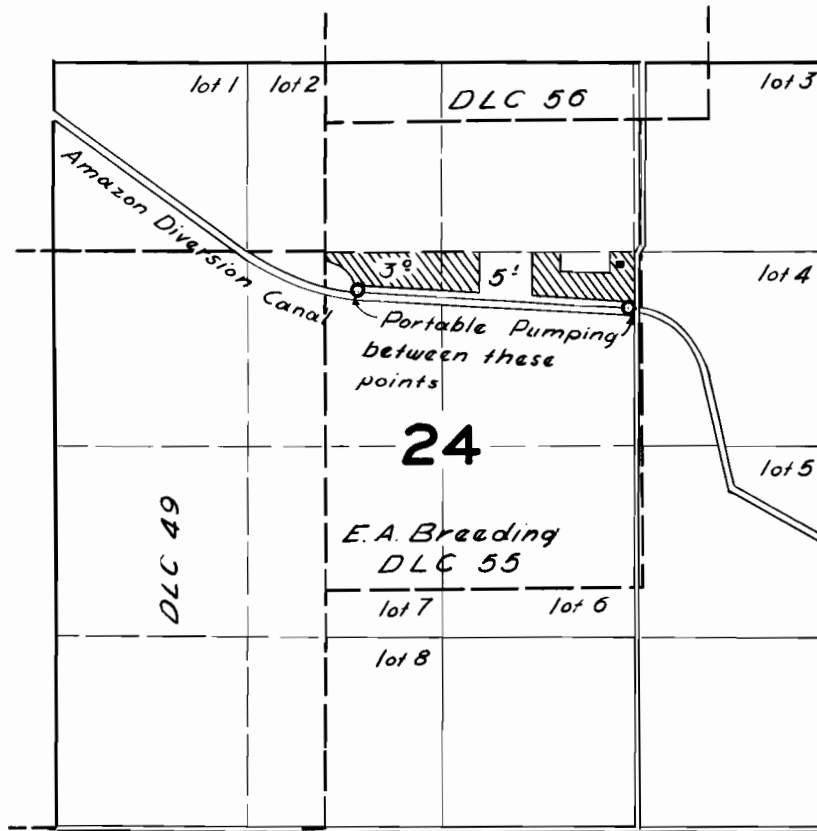

FINAL PROOF SURVEY UNDER

Application No. 27318 Permit No. 21480
IN NAME OF

CLAYTON A. LAWRENCE

Surveyed 30 Apr. 1957, by *C. A. Whitby*