


T.22 S.R.6 W.W.M.

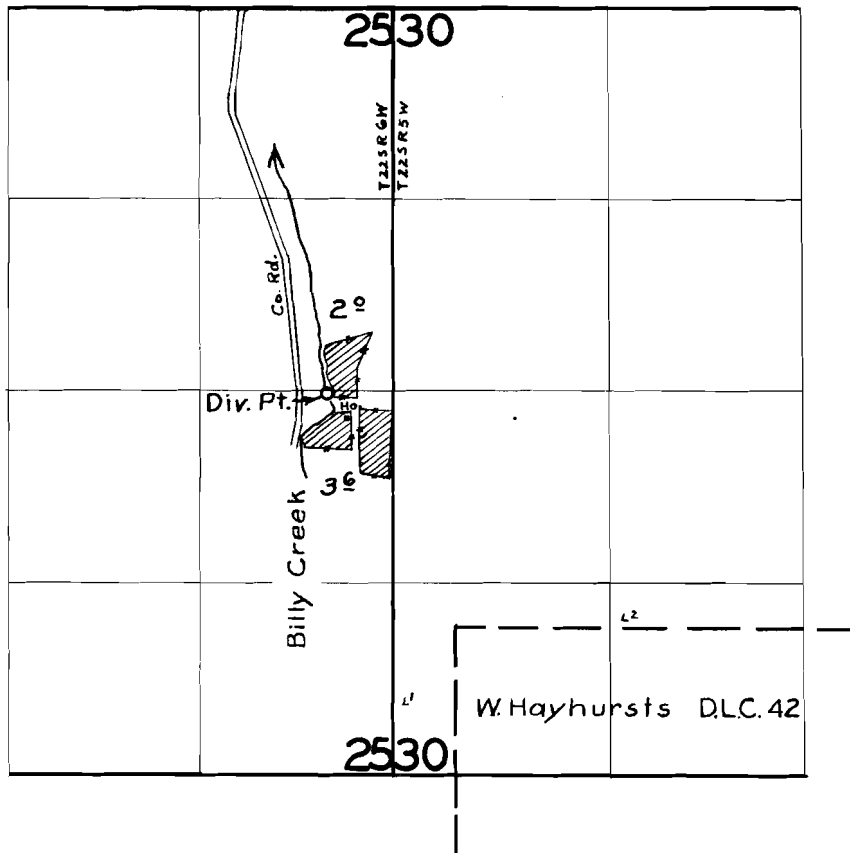

**FINAL PROOF SURVEY**  
UNDER

Application No. 27325 Permit No. 21485  
IN NAME OF

Robert J. Hillyer

Surveyed Sept. 10, 1957, by M. Beck