


T.25 S.R.4 W.W.M.

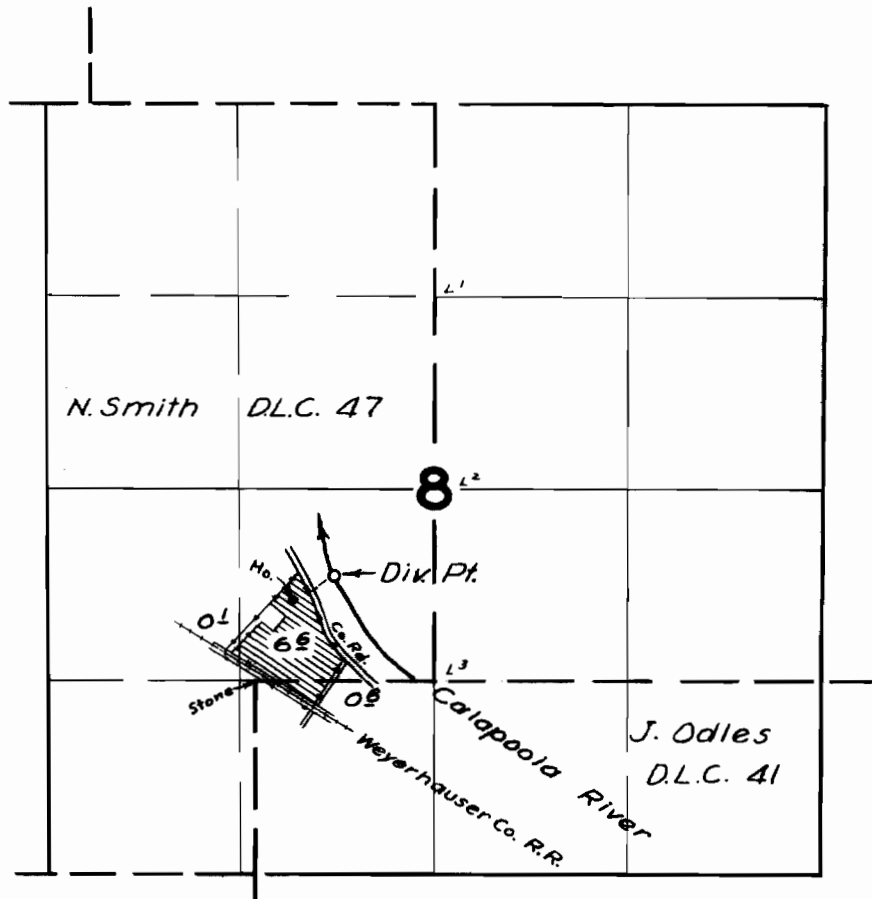

FINAL PROOF SURVEY UNDER

Application No. 25964... Permit No. 21509...
IN NAME OF

H.R. Geider

Surveyed Aug. 17, 1957, by *M. Beck*