


T.6S.R.7W.W.M.

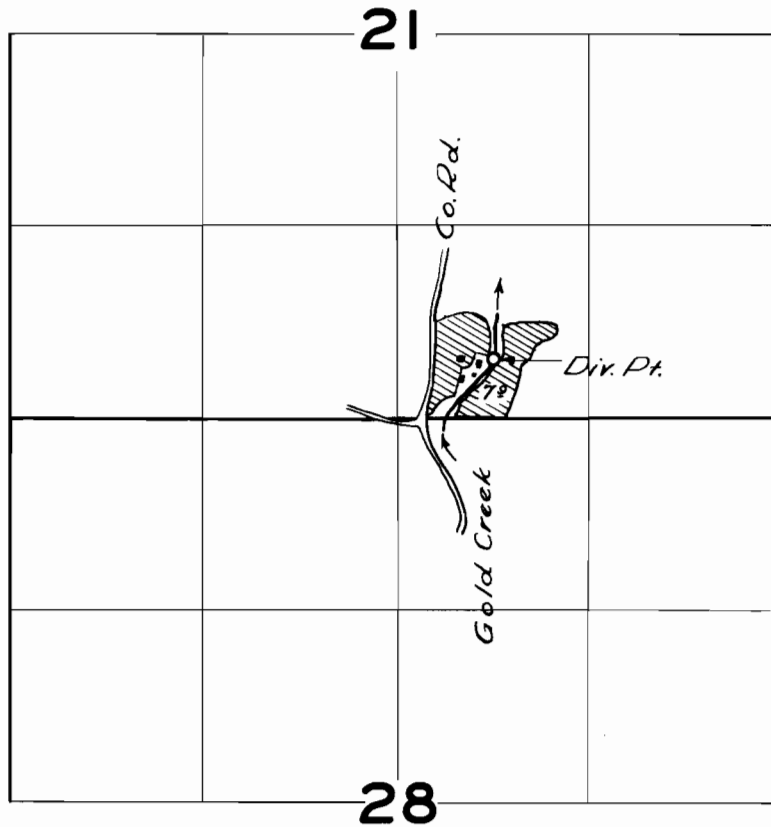

FINAL PROOF SURVEY
UNDER

Application No. 27443 Permit No. 21606
IN NAME OF

PAUL D. & DOROTHY E. WAGLER

Surveyed 29 July 1957, by Paul Lilly