


# T.29S.R.5W.W.M.

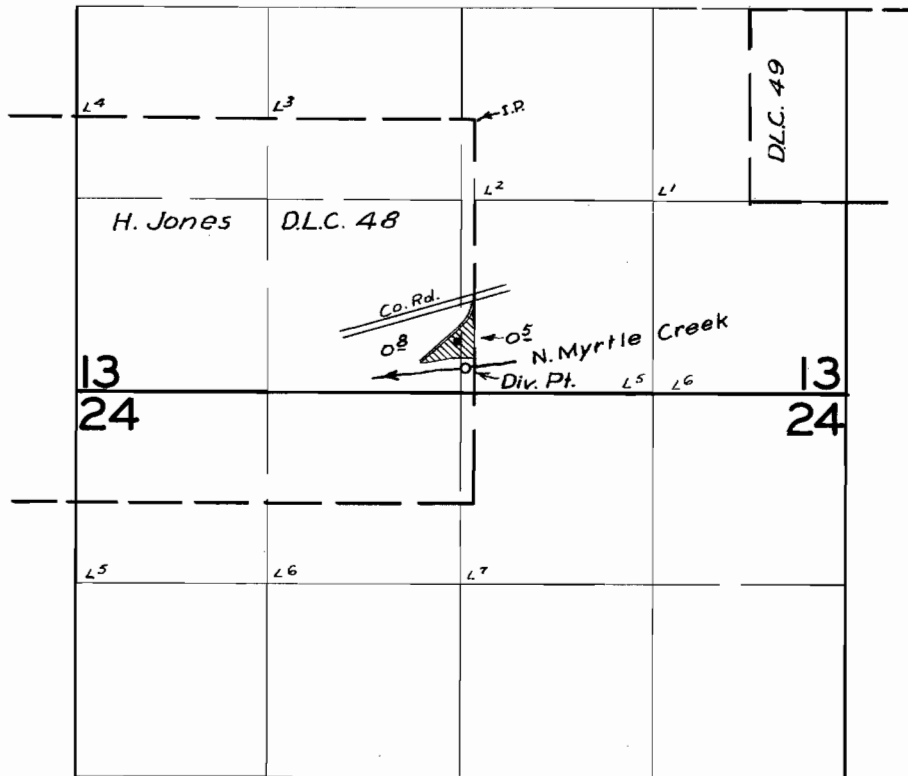

## FINAL PROOF SURVEY UNDER

Application No. 27658 Permit No. 21783  
IN NAME OF

C. W. Bare

Surveyed July 24 1957, by M. Bick