


T.18S.R.10W.W.M.

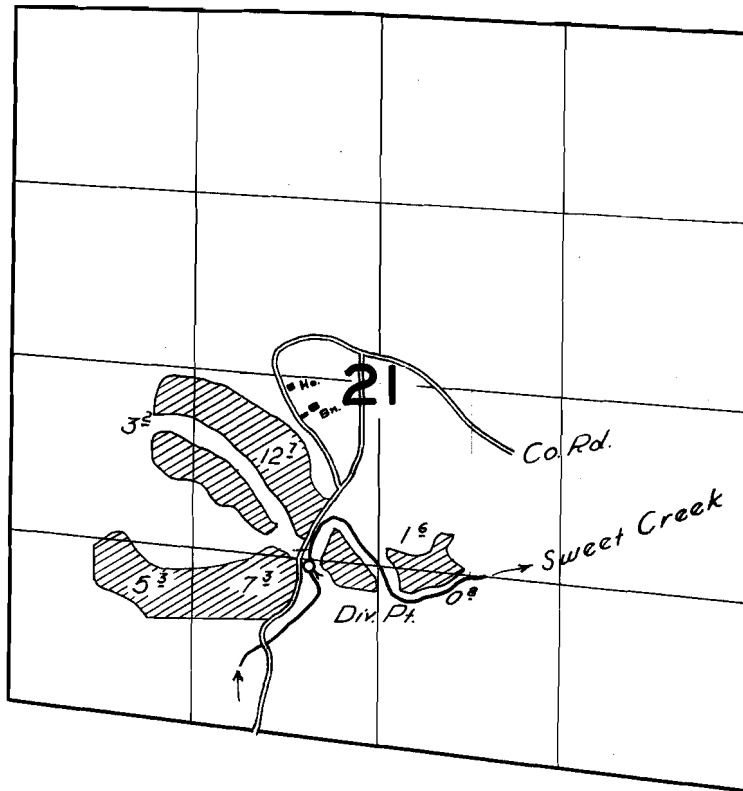

FINAL PROOF SURVEY
UNDER

Application No. 27749 Permit No. 21851
IN NAME OF

ELTON DEAN

Surveyed 27 May 1957, by [Signature]