


# T.10S.R.10W.W.M.

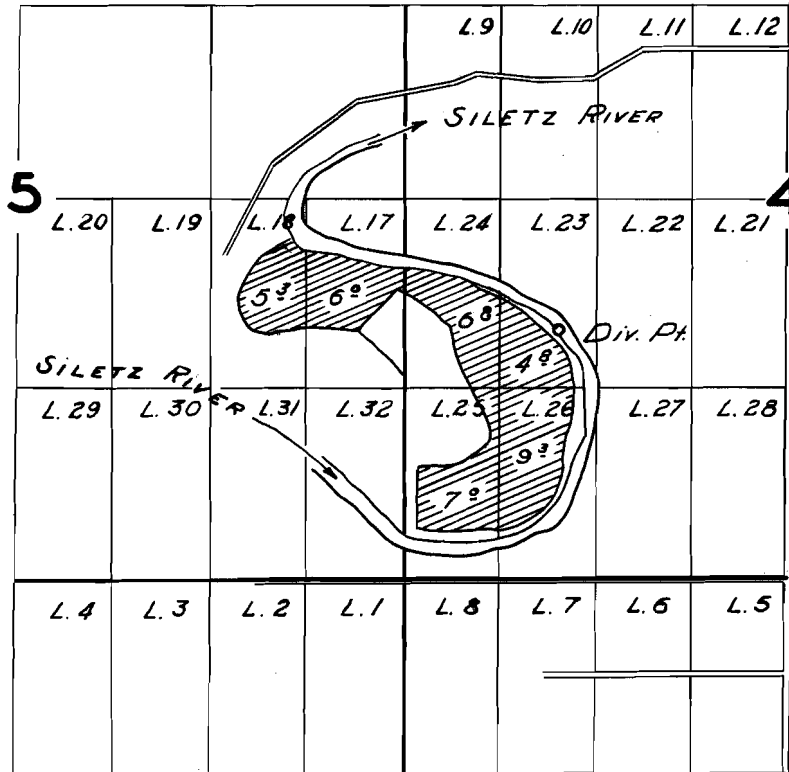

## FINAL PROOF SURVEY

UNDER

Application No. 27828 Permit No. 21889

IN NAME OF

G. C. BRATLAND

Surveyed 6 Aug 1957, by [Signature]