


T.30S.R.5W.W.M.

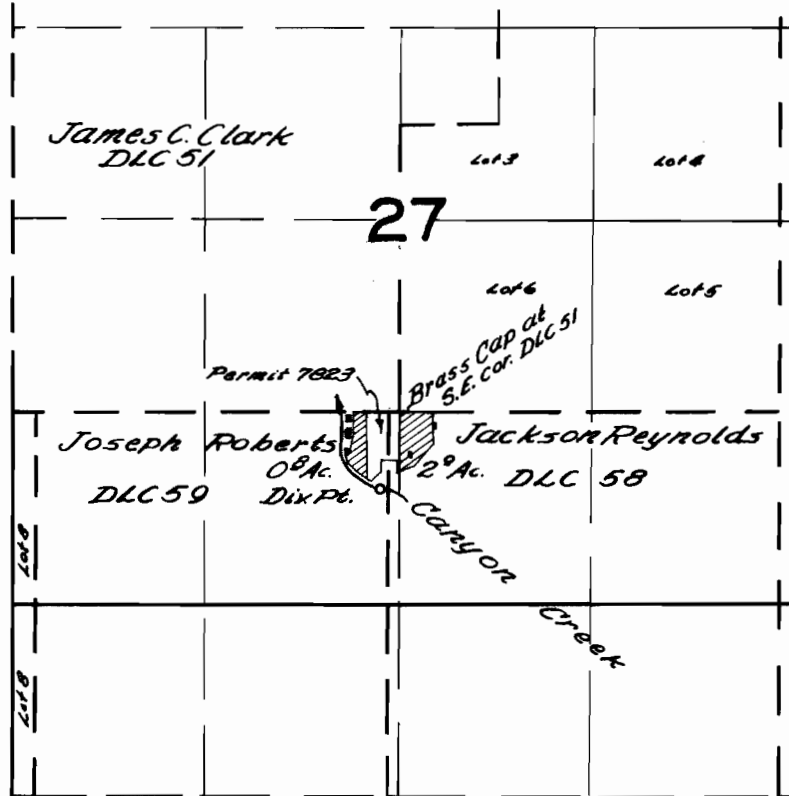

FINAL PROOF SURVEY UNDER

Application No. 26195 Permit No. 21920
IN NAME OF

CANYONVILLE BIBLE ACADEMY

Surveyed April 15, 1957, by C. O. Bartels