


T.17S.R.6W.W.M.

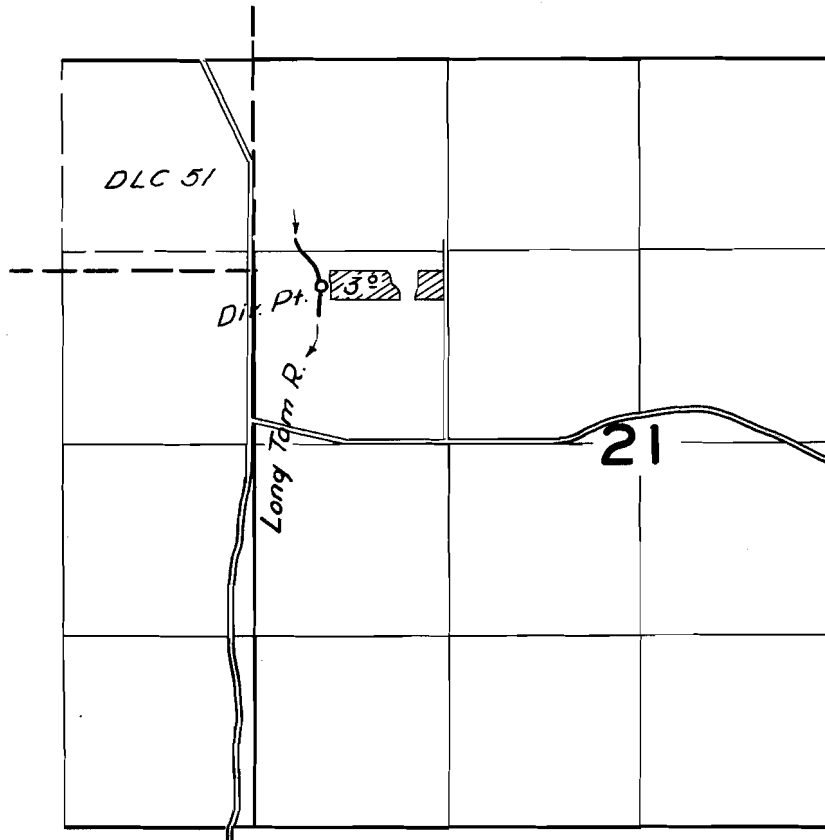

FINAL PROOF SURVEY

UNDER

Application No. 27850 Permit No. 21953

IN NAME OF

H. H. & H. D. DRUMMONDS

Surveyed 8 May 1957, by [Signature]