


# T.22 S.R.8W.W.M.

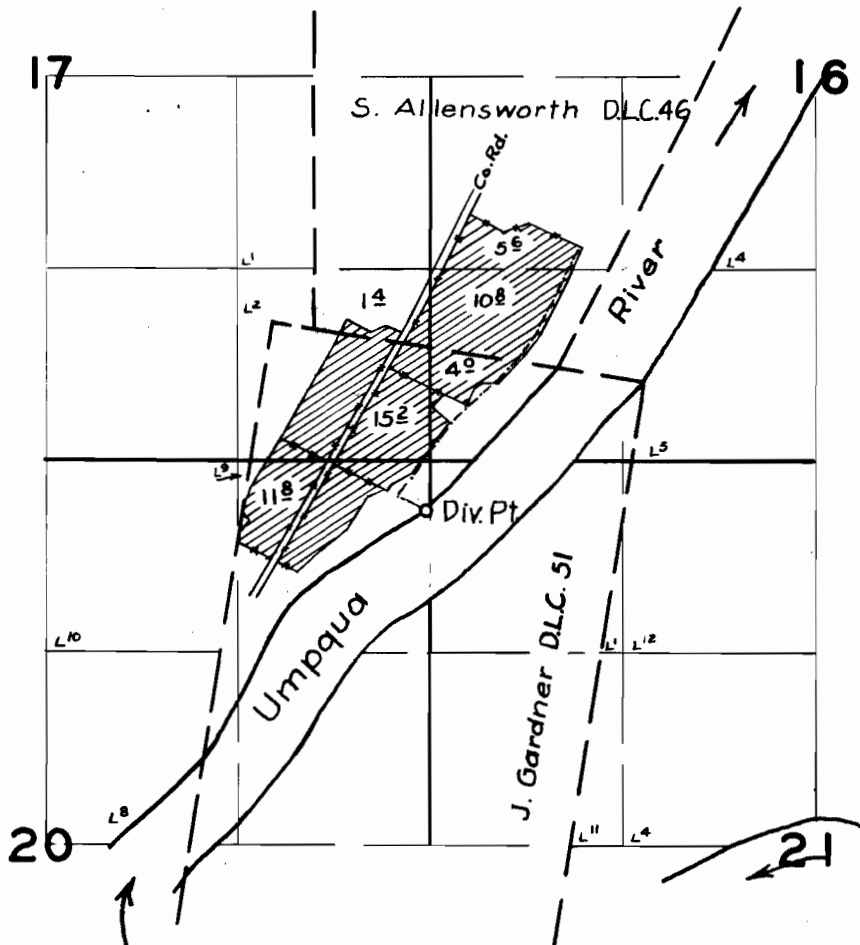

## FINAL PROOF SURVEY UNDER

Application No. 27959 Permit No. 22010  
IN NAME OF

C. G. Hedden

Surveyed Sept. 9, 1957, by *T. B. Bish*