


T. 2S. R. 9W. W.M.

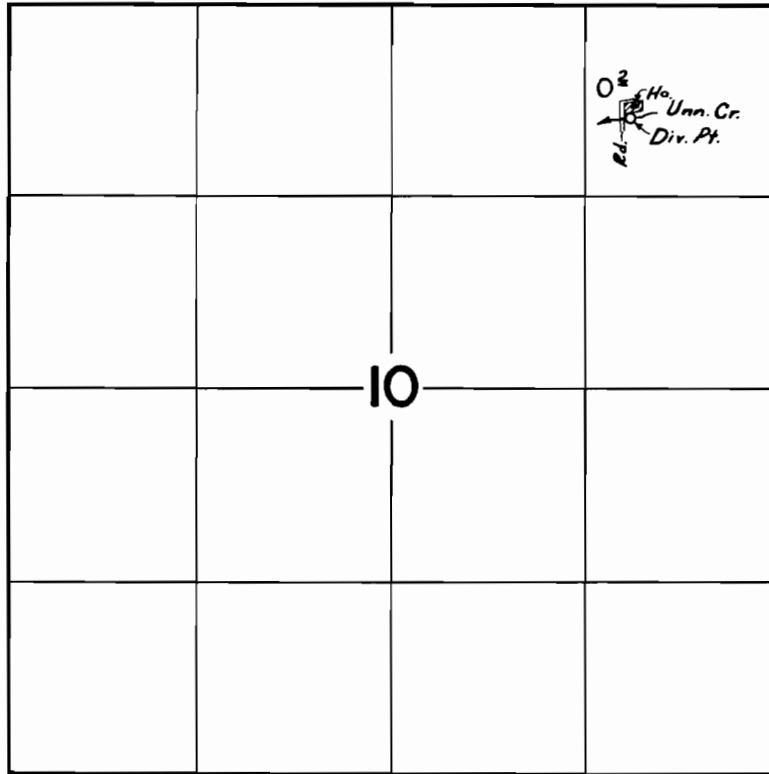

FINAL PROOF SURVEY
UNDER

Application No. 2799.4 Permit No. 22033
IN NAME OF

EMMA & BERNARD GROSSEN

Surveyed AUG. 26, 1957, by *Edwin H. Smith*