


T.13S.R.10W.W.M.

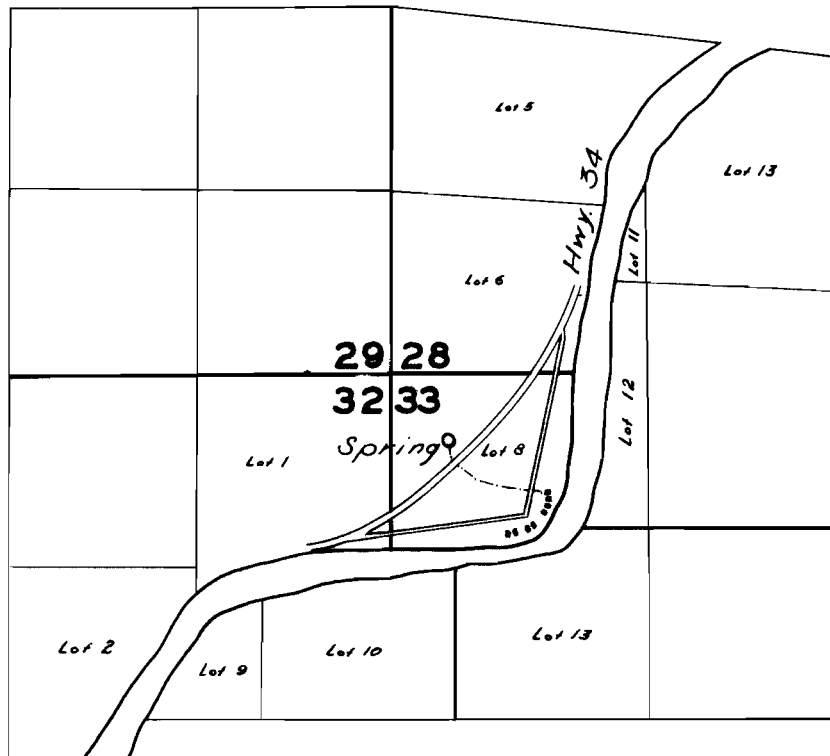

FINAL PROOF SURVEY UNDER

Application No. 28161 Permit No. 22162
IN NAME OF

EVERETT W. CROUCH

Surveyed 11 June 1957, by R. L. Skiff