


T. 30S. R. 5W. W.M.

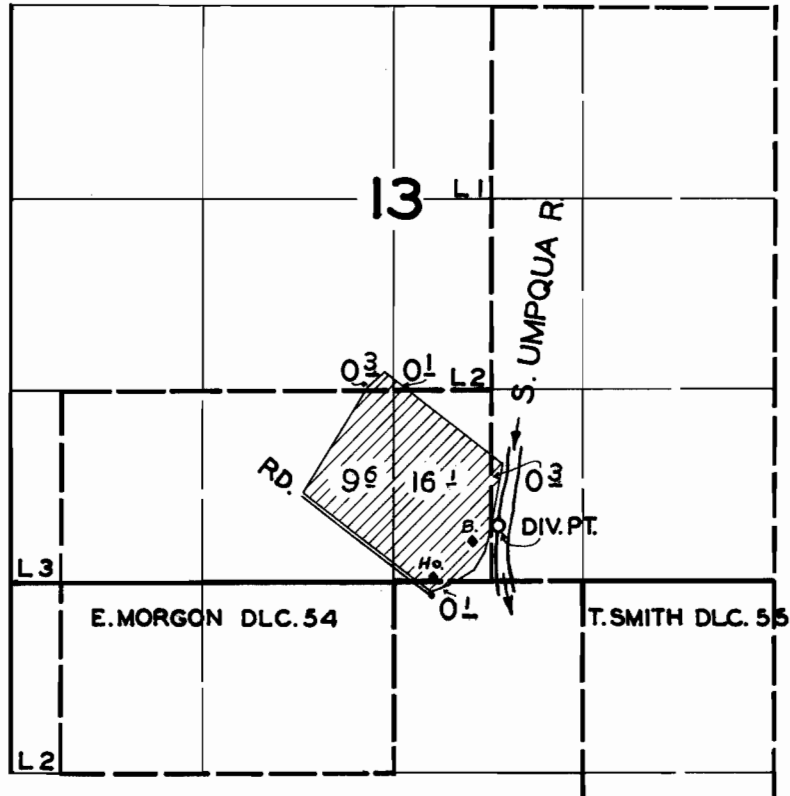

FINAL PROOF SURVEY  
UNDER

Application No. 28311 Permit No. 22260  
IN NAME OF

PEARL ULAM

Surveyed OCT. 14, 1956, by *[Signature]*