


T.6S.R.7W.W.M.

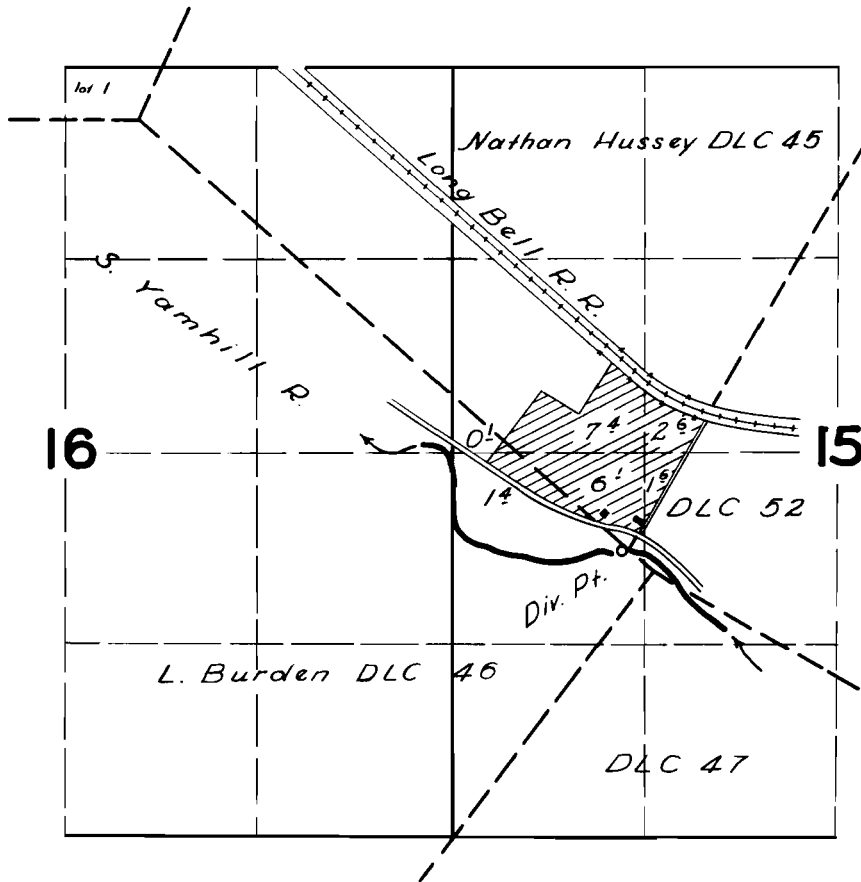

FINAL PROOF SURVEY
UNDER

Application No. 28448 Permit No. 22284
IN NAME OF

D. D. WILLIS

Surveyed 26 July 1957, by [Signature]