


T.17S.R.7W.W.M.

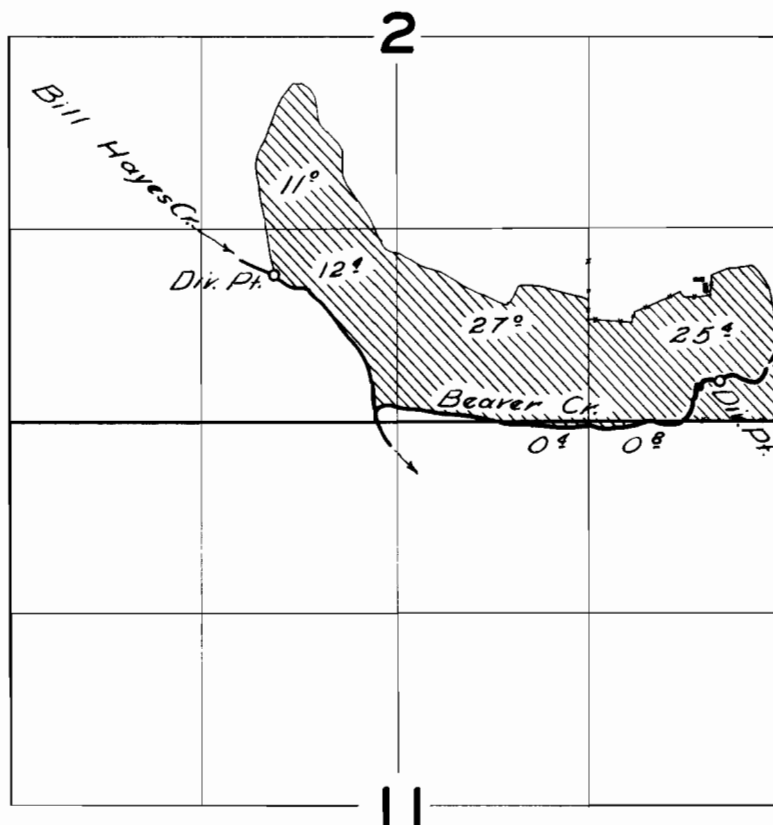

FINAL PROOF SURVEY

UNDER

Application No. 28549 Permit No. 22331

IN NAME OF

H. R., W. H. & R. C. SWANSON & M. B. MARSH

Surveyed 14 May 1957, by *[Signature]*