


# T18SRIEWM

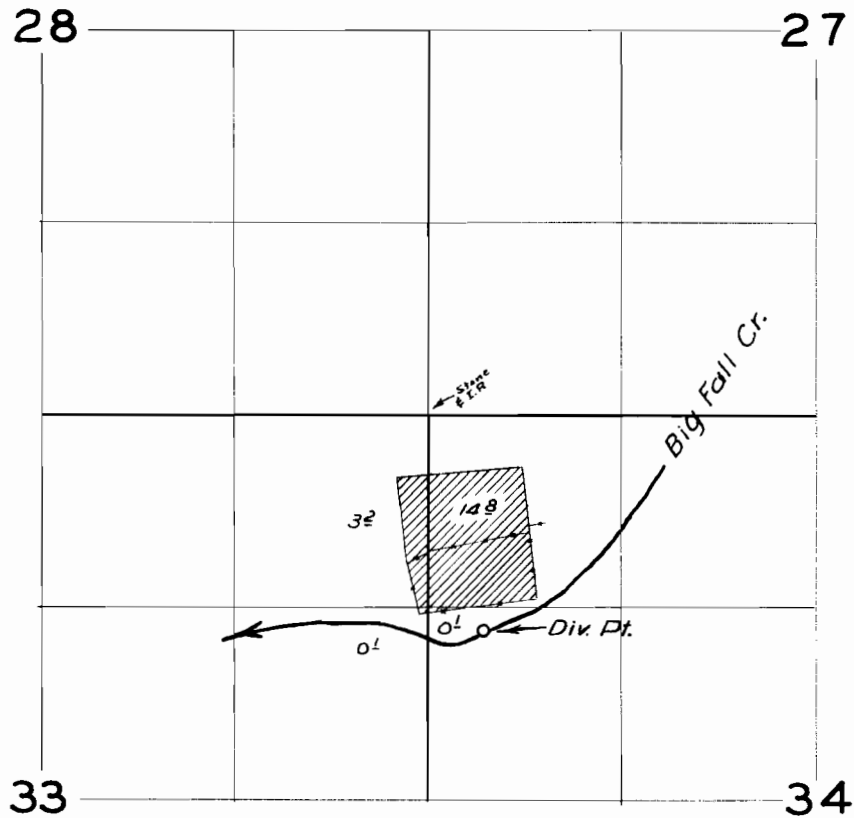

## FINAL PROOF SURVEY UNDER

Application No. 28449 Permit No. 22493  
IN NAME OF

*Vern L. Hucka*

Surveyed June 18 1957, by *M. Bial*