


T. 29 S. R. 5 W. W.M.

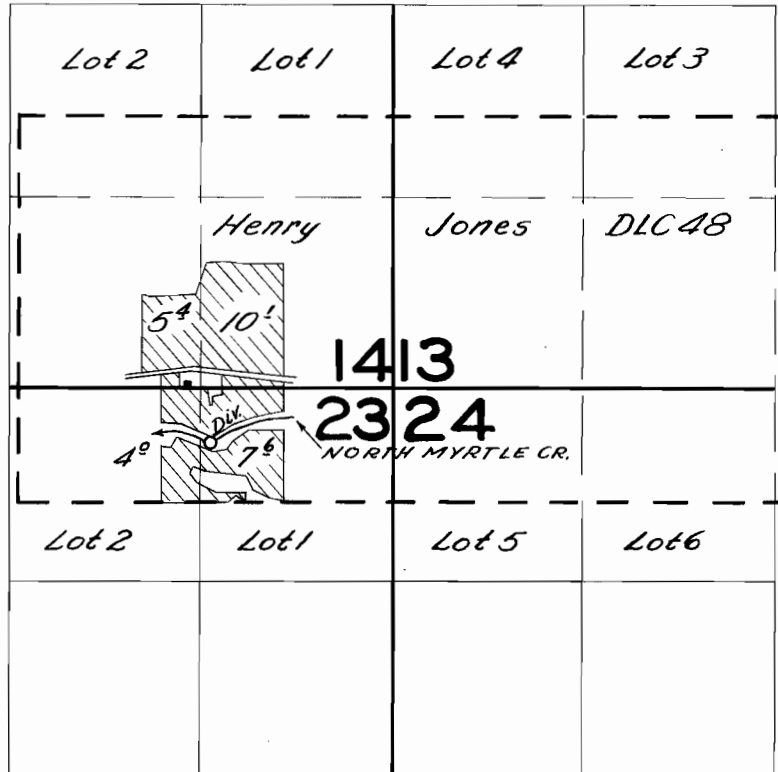

FINAL PROOF SURVEY UNDER

Application No. 28456 Permit No. 22561
IN NAME OF

CHAS. JONES

Surveyed April 14, 1957, by C.O. Baile