


T.7S.R.5W.W.M.

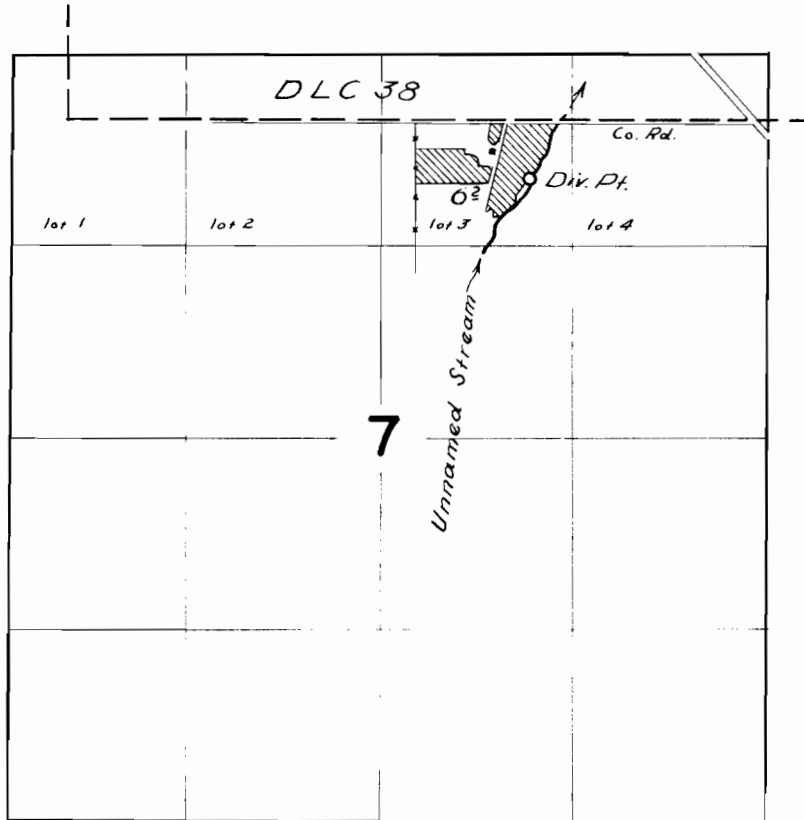

**FINAL PROOF SURVEY**  
UNDER

Application No. 28668, Permit No. 22575  
IN NAME OF

*MARVIN R. MAY*

Surveyed 25 July 1957, by *[Signature]*