


T. 10S. R. 5E. W.M.

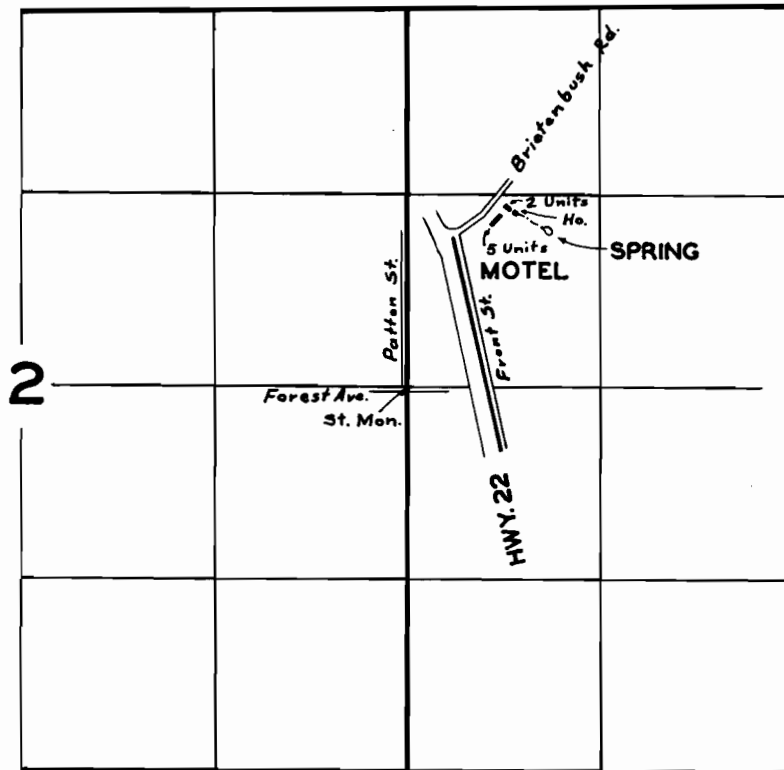

FINAL PROOF SURVEY
UNDER

Application No. **28807** Permit No. **22672**
IN NAME OF

A.L. & ROSEMARY BARKER

Surveyed OCT. 11, 1957, by *M. Bish*