


T.27S.R.6W.W.M.

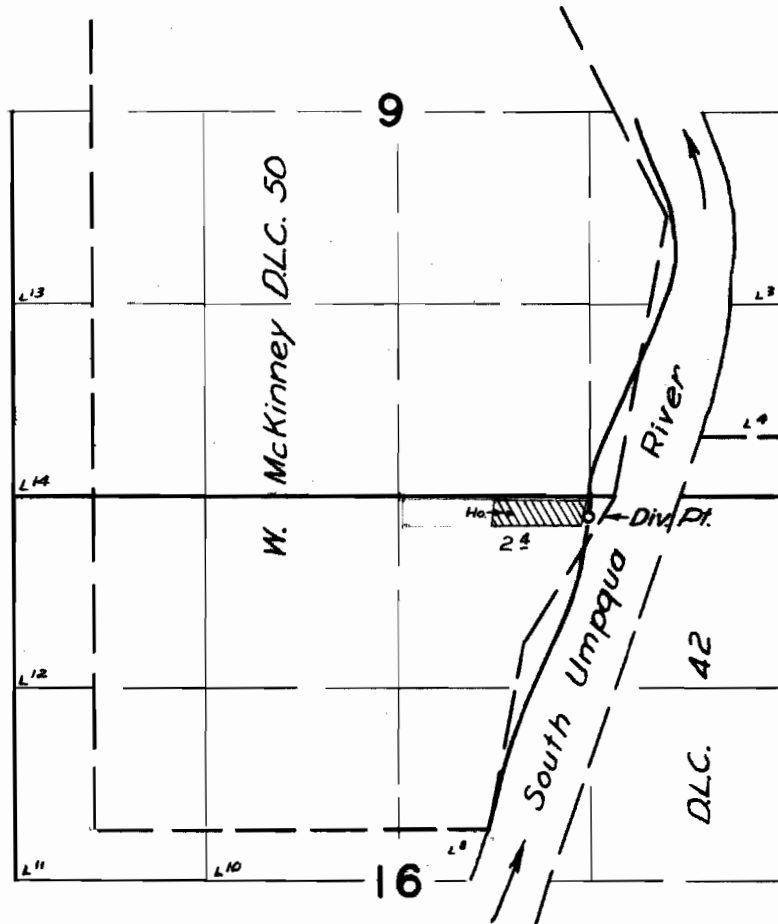

FINAL PROOF SURVEY
UNDER

Application No. 28809 Permit No. 22674
IN NAME OF

Oren L. & Edna M. Burnett

Surveyed July 18, 1957, by Tr. Bush