

7 8
 18 17



SCALE 1" = 400'

ROSS R. DEAN WATER RIGHT
DIVERSION SEC 7 USE SEC 18 T1S R8W
TILLAMOOK COUNTY


I, W. A. Markham of Arch Cape, Ore, hereby certify that this map is made from notes of an actual survey made by me on Jan. 29, 1954; that the monument shown, an iron pipe 1" x 4", is North 701.6 feet and West 1773.7 feet from SE Corner of Sec 7 T1S R8W W.M.

W. A. Markham
 Reg. Engr # 1842

Application No. 28997
 Permit No. 22798

28997
RECEIVED
 FEB 4 1954
 STATE ENGINEER
 SALEM, OREGON

T. 15. R. 8W. W.M.

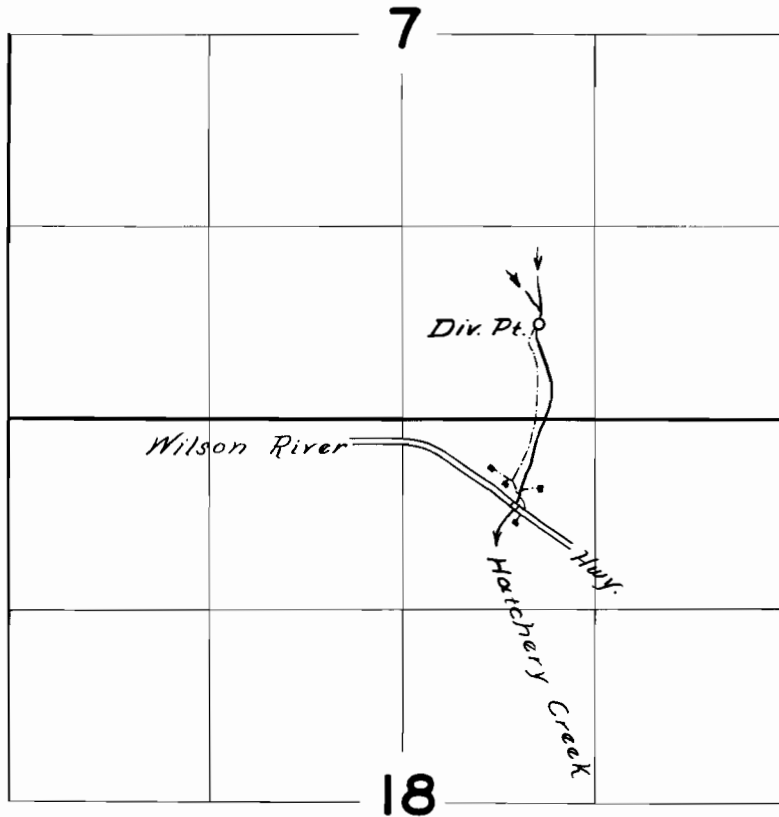

FINAL PROOF SURVEY
UNDER

Application No. 28997 Permit No. 22798
IN NAME OF

ROSS R. DEAN

Surveyed 11 Aug 1957, by C. W. White